


T.22S.R.5W.W.M.

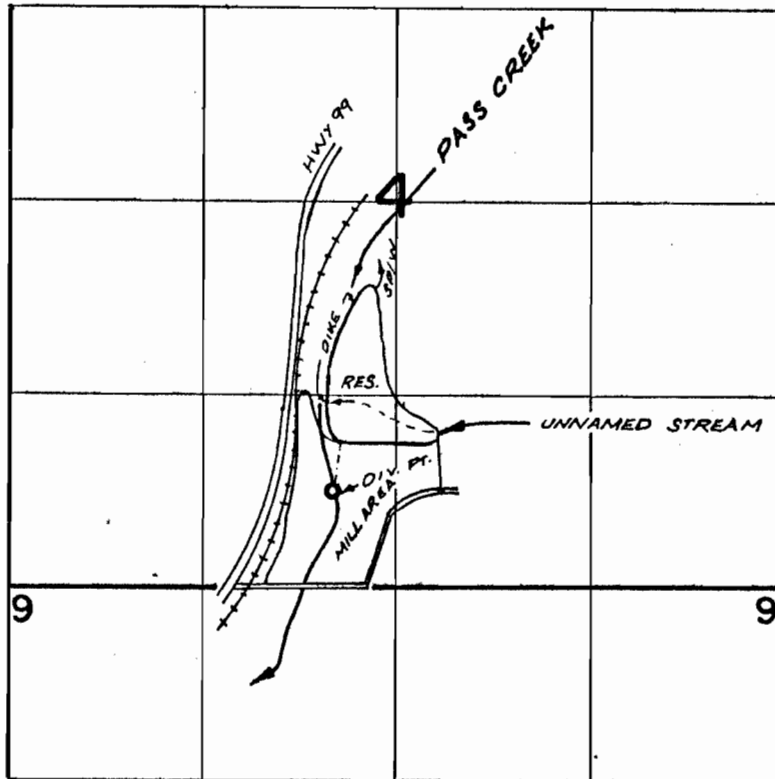

DIV. PTS. LOC: 1370'S. & 2150'E; 1970'S. & 2200'E, BOTH FROM
W. 1/4 COR. SEC. 4

FINAL PROOF SURVEY

UNDER

Application No. R-43741 43742 Permit No. R-5034 32750

IN NAME OF

SMITH RIVER LUMBER COMPANY

Surveyed JUNE 2, 1970, by R. MUCKEN