


T.22S.R.7&8W.W.M.

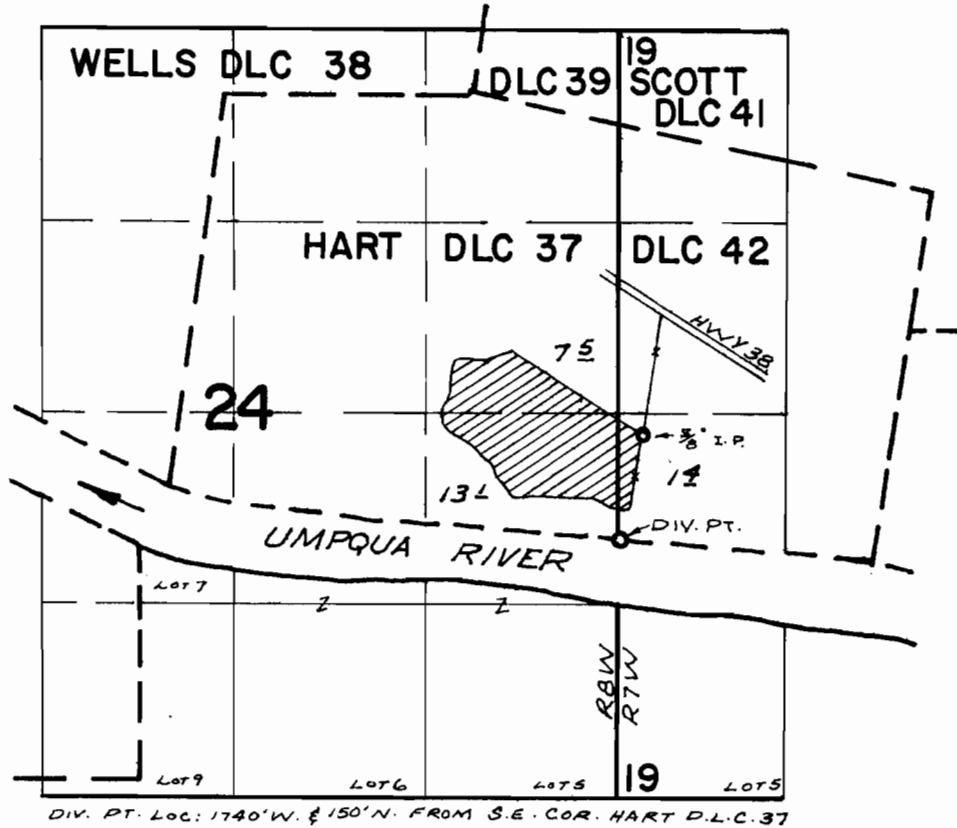

FINAL PROOF SURVEY

UNDER

Application No. 45298 Permit No. 33021

IN NAME OF

HOWARD E. CARNES

Surveyed JUNE 4, 1970, by R. MUCKEN