


T.26S. R.4W.W.M.

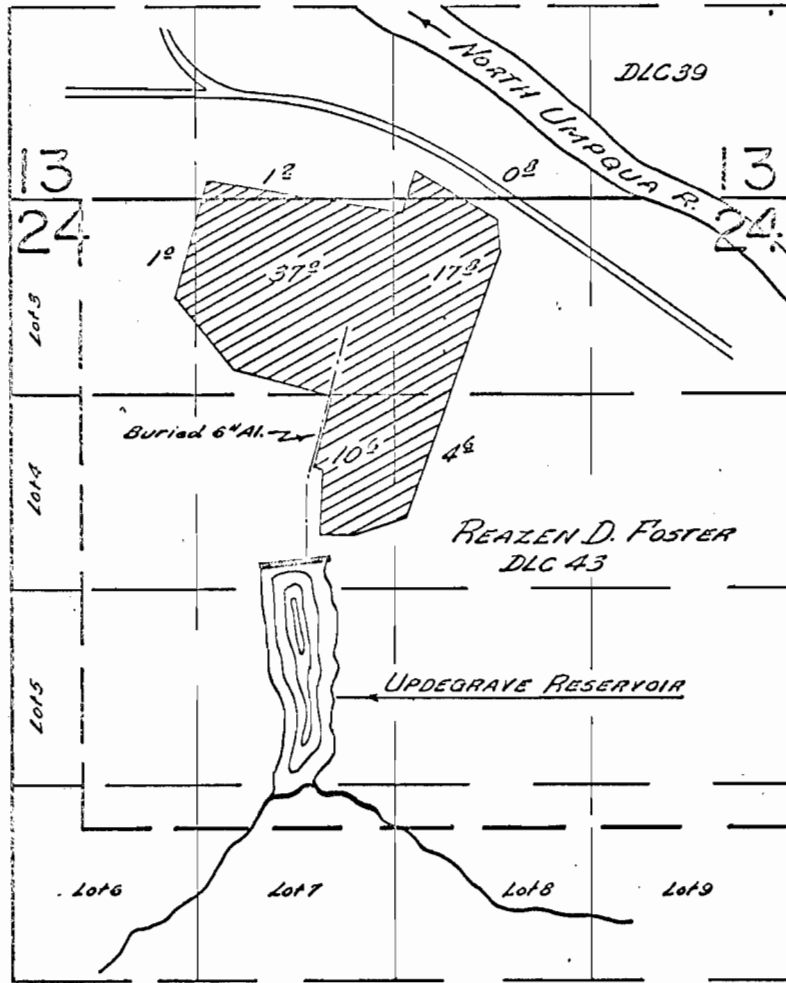

FINAL PROOF SURVEY  
UNDER

Application No. R-45863

Permit No. 45864  
R-5405  
34063

R-31592 R-2025  
Application No. ...31593... Permit No. ...24921...  
IN NAME OF

.....William Updegrave.....

Surveyed April 1, 1963, by C.O. Bartels.....