


T. 35 S. R. 6 W. W.M.

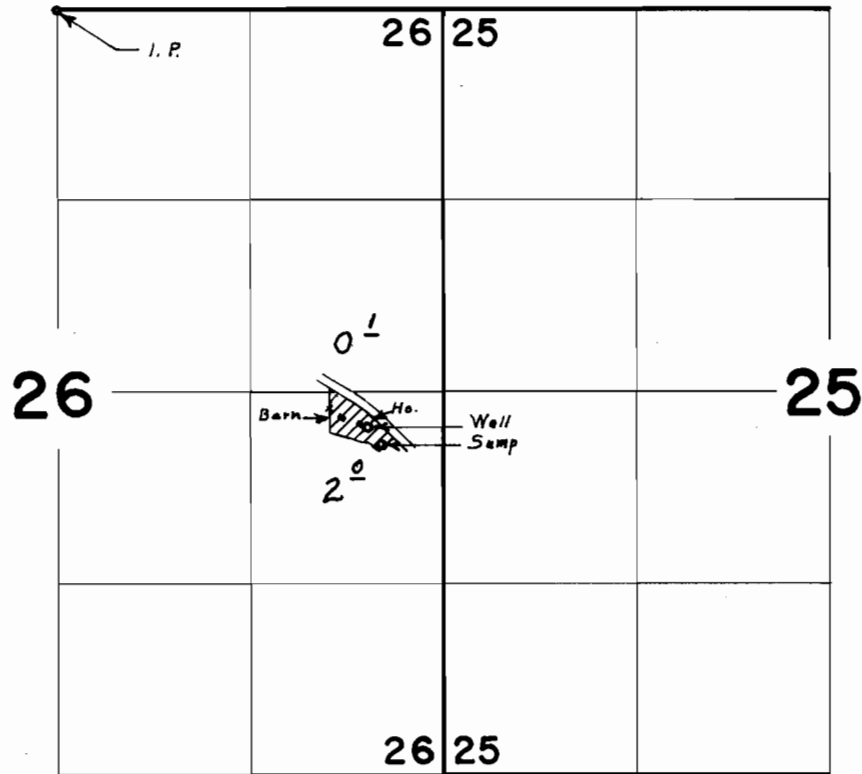

Wells located: well, 2870' S. & 2120' E.; Sump, 2980' S. & 2200' E.;
both from N. & Cor. Sec. 26

FINAL PROOF SURVEY

UNDER

Application No. G-3151 Permit No. G-2967

IN NAME OF

DONALD B. & NELLIE RAE DEAN

Surveyed April 16, 1970, by L. E. Gould