


T. 34S.R.6W.W.M.

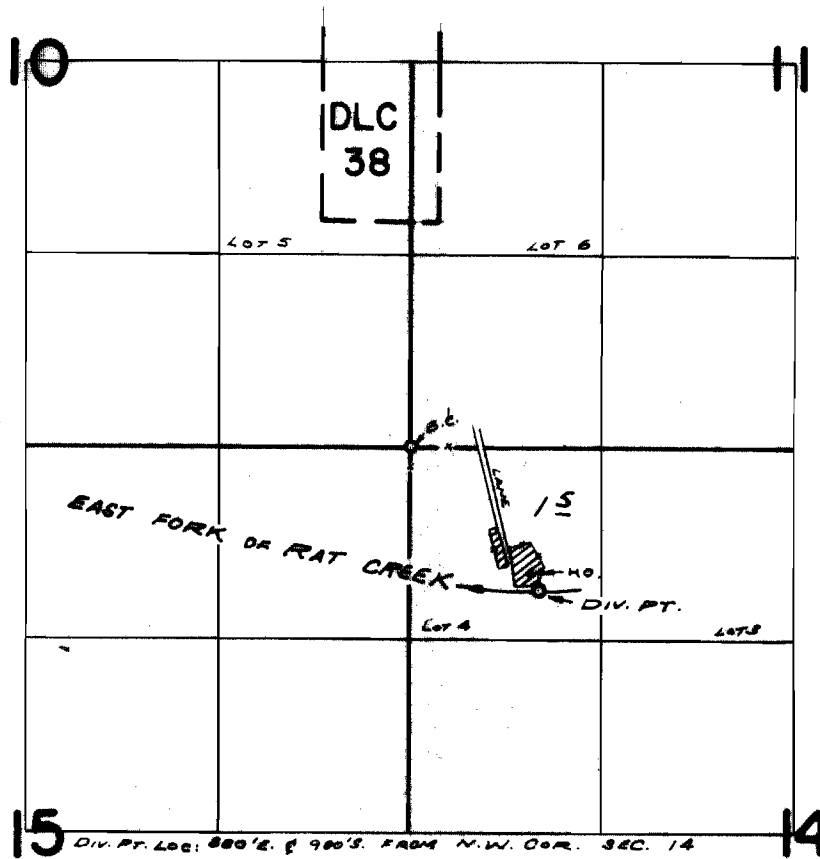

**FINAL PROOF SURVEY
UNDER**

Application No. 37057... Permit No. 27571...
IN NAME OF

CARL & FLORENCE WESTMAN

Surveyed APRIL 14, 1970, by R. MUCKEN...