


T.34S.R.6W.W.M.

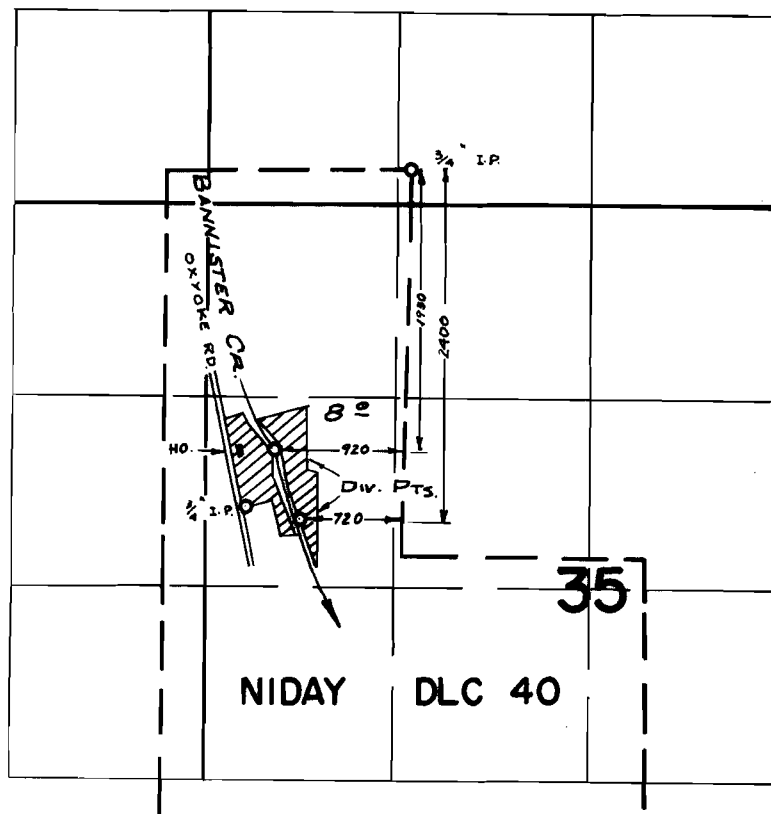

FINAL PROOF SURVEY
UNDER

Application No. 40749... Permit No. 30347...
IN NAME OF

A. E. SHAWLEY

Surveyed APR. 29, 1970, by R. MUCKEN...