


T. 36 S. R. 6 W. W. M.

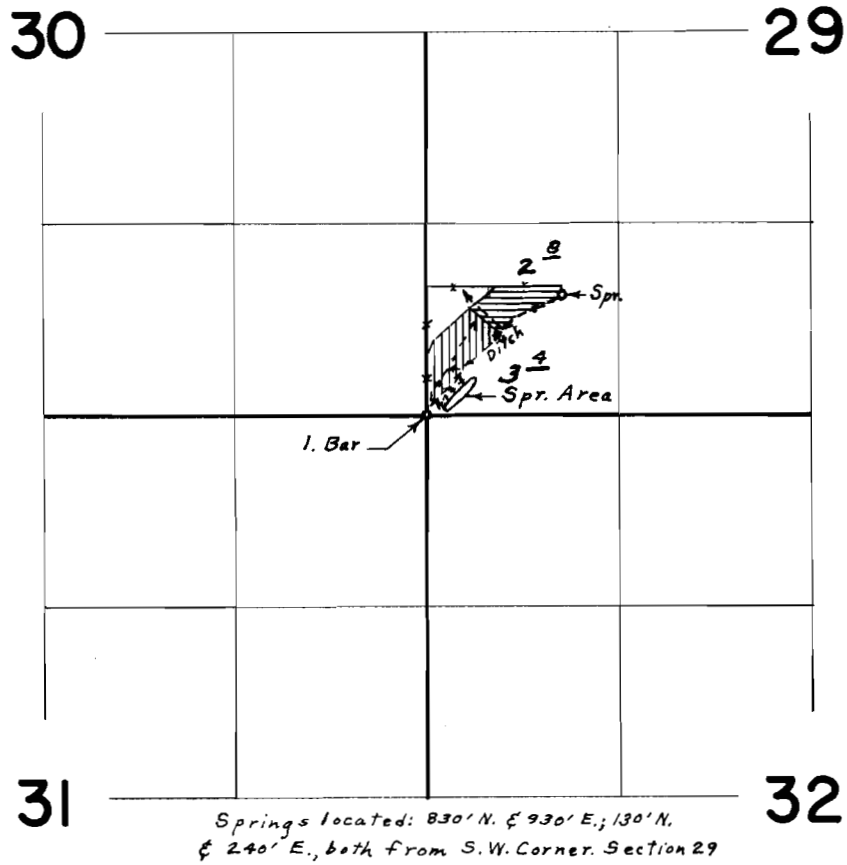

FINAL PROOF SURVEY

UNDER

Application No. 42003 Permit No. 31434

IN NAME OF

WILLIAM E. & MARY A. PHILLIPS

Surveyed April 30, 1970, by L. E. Gould