


T.34S.R.6W.W.M.

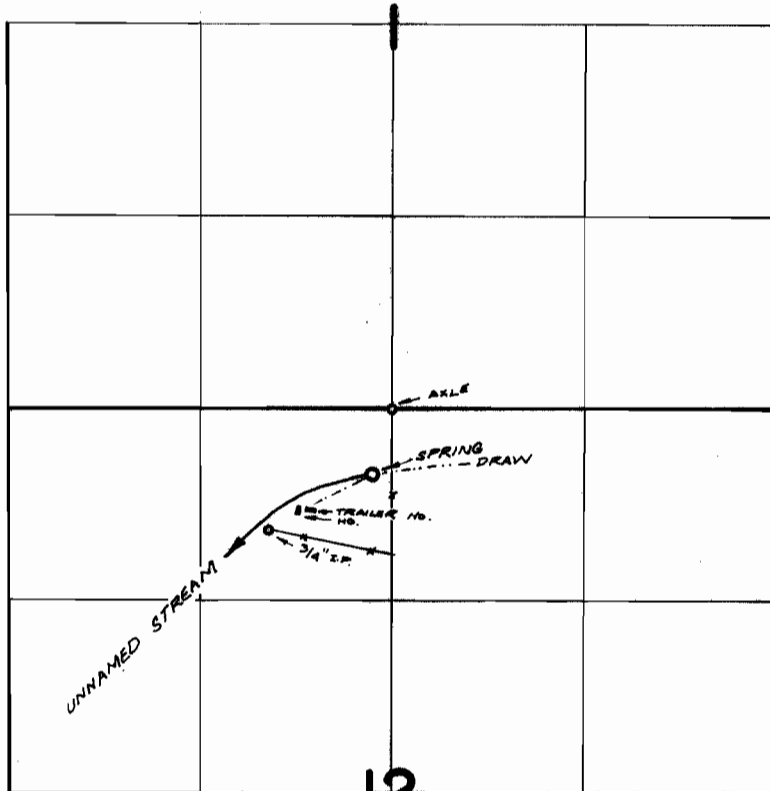

12

DIV. PT. LOC: 450'S. & 130'W. FROM N. 1/4 COR. SEC. 12

FINAL PROOF SURVEY
UNDER

Application No. 43622 Permit No. 32625
IN NAME OF

DORTHEA M. BROCK

Surveyed APRIL 16, 1970, by R. MUCKEN