


G-3214
38085 14

T.38S.R.10E.W.M.

Swan Lake well

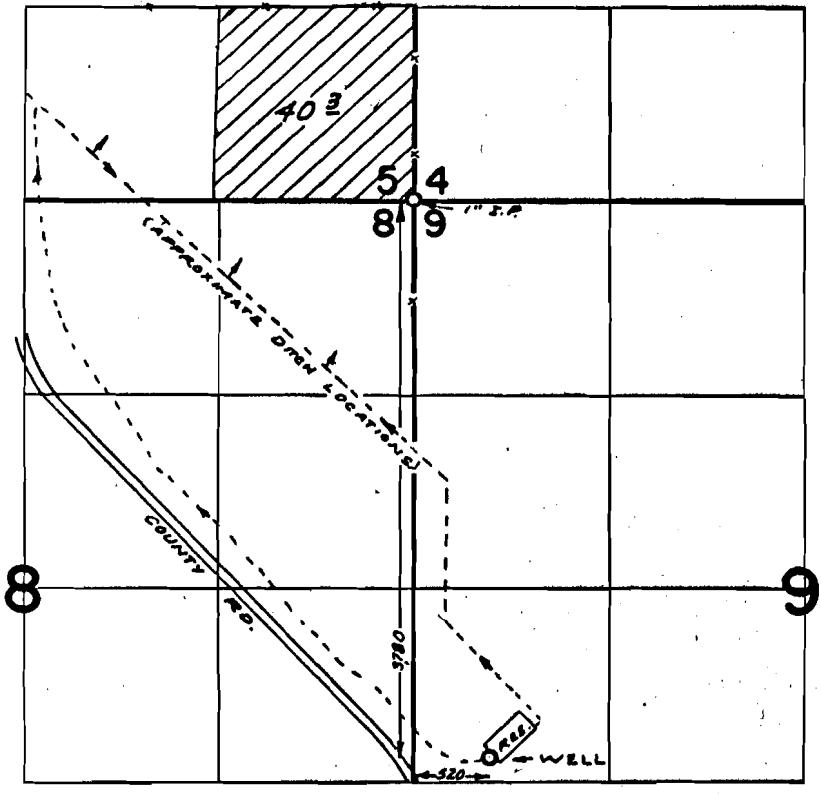

FINAL PROOF SURVEY UNDER

Application No. G-3428 Permit No. G-3214
IN NAME OF

DELBERT & SAM DEHLINGER

Surveyed MAY 12, 1970, by R. MUCKEN