


G-3547
3808614

T.36S.R.12E.W.M.

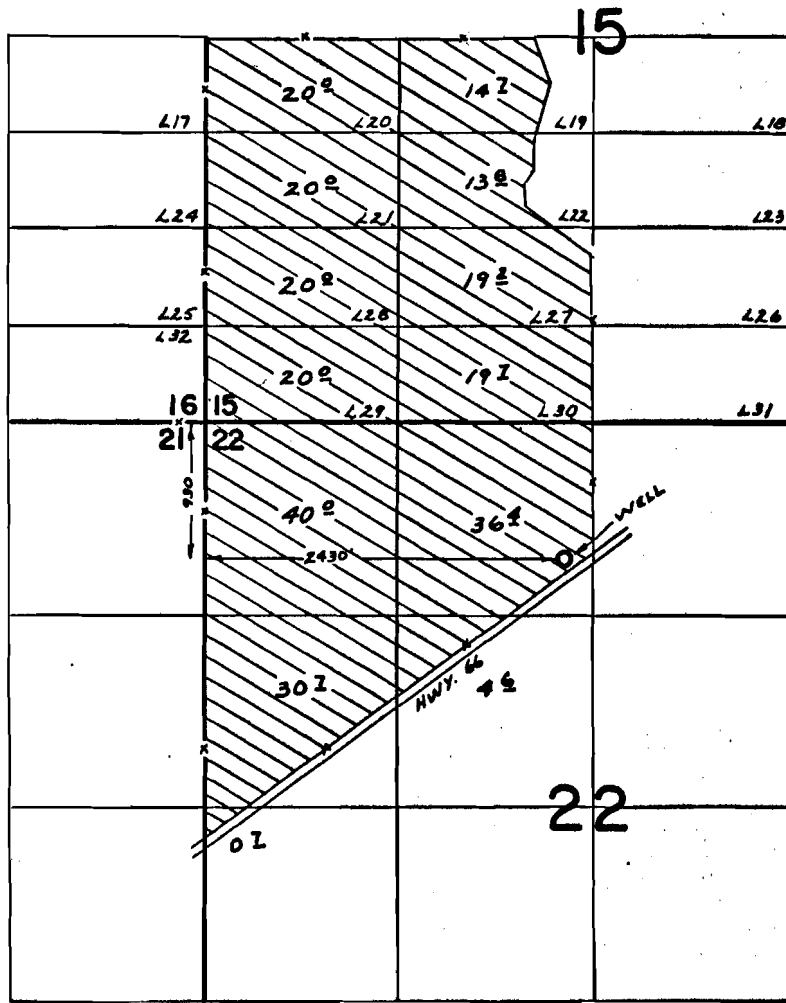

Sprague River Wells

FINAL PROOF SURVEY UNDER

Application No. G-3758... Permit No. G-3547.
IN NAME OF

HOMER & INEZ DeLAMATER

Surveyed MAY 18, 1970, by R. MUCKEN