


G-3602
38087 14

T. 39S. R. 11E. W. M.

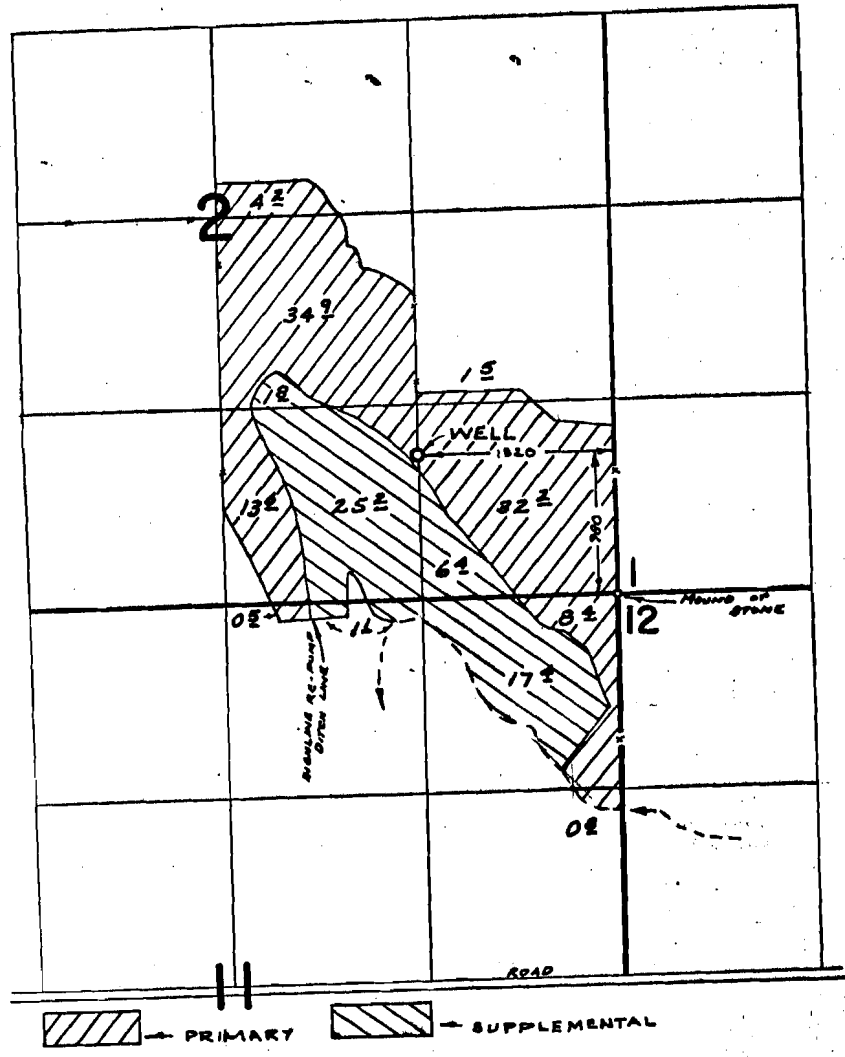

East River wells

FINAL PROOF SURVEY UNDER

Application No. G-3817 Permit No. G-3602
IN NAME OF

DONALD J. HORSLEY

Surveyed SEPT. 17 1970, by E. BACA