


28441
38088 14

T.35S.R.13E.W.M.

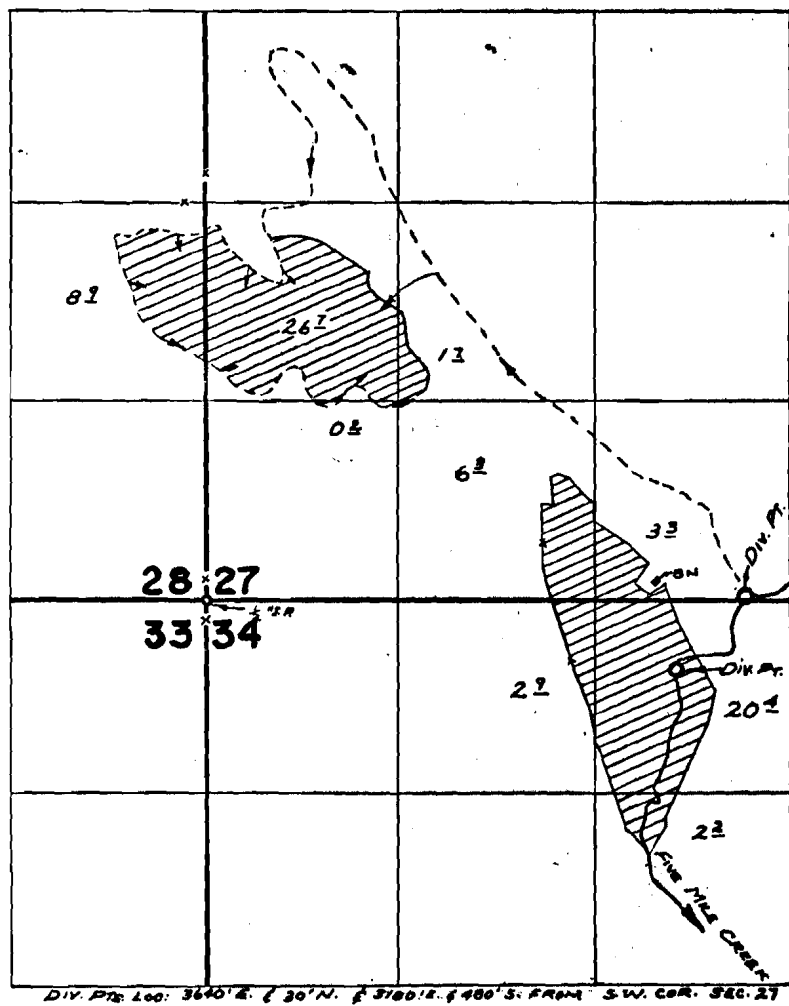

11. Sk. Sprague Co. & Mead.

FINAL PROOF SURVEY UNDER

Application No. 38151..... Permit No. 28441.....
IN NAME OF
**PERCY & MARCELLA H. MURRAY &
WILLIAM V. & DORIS MEADE**

Surveyed MAY 21, 1970, by R. MUCKEN.....