


G 1731 13
38090

T.37S.R.20E.W.M.

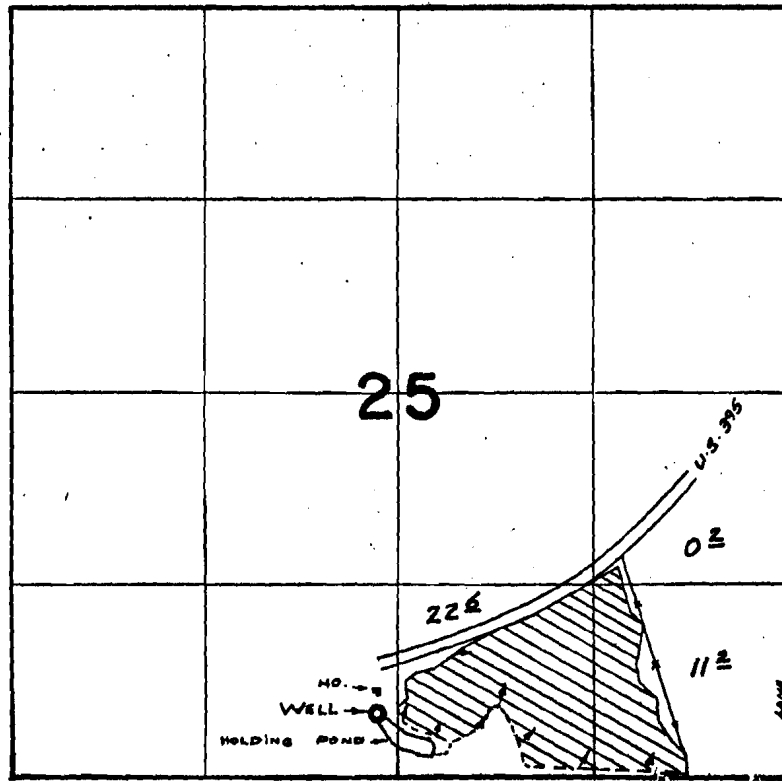

WELL LOC: 430' N. & 2780' W. FROM S.E. COR. SEC. 25

FINAL PROOF SURVEY

UNDER

Application No. G-1892 Permit No. G-1731

IN NAME OF

WALTER M. CORY

Surveyed July 14, 1970, by R. MUCKEN