


G 2386 13
38091

T. 33 S. R. 18 E. W. M.

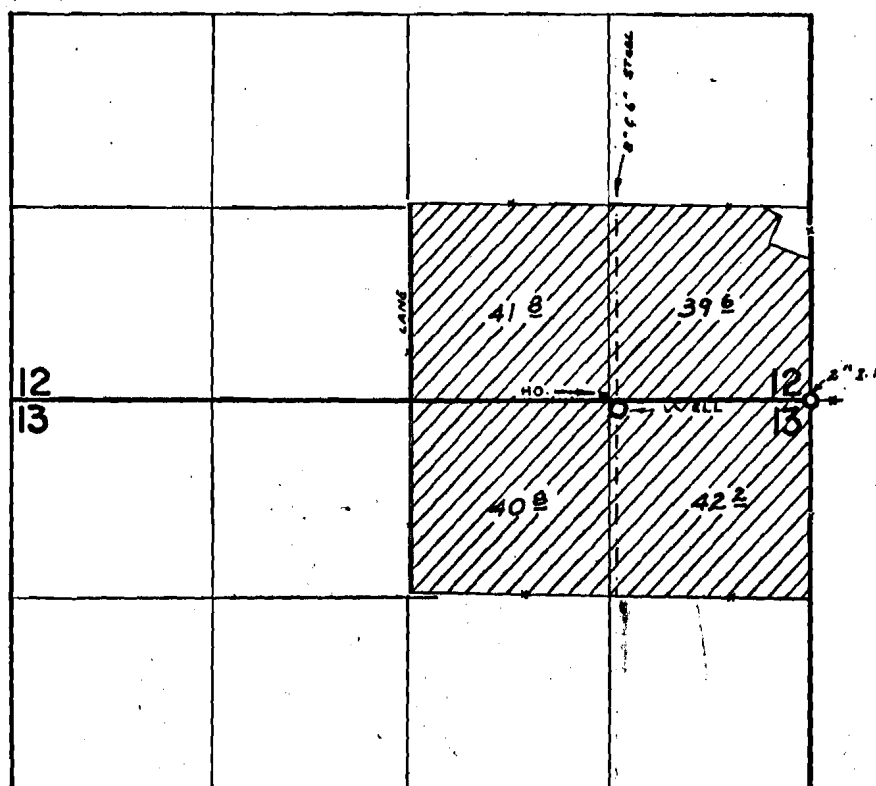

WELL LOC: 60' S. & 1300' W. FROM N.E. COR. SEC. 13

FINAL PROOF SURVEY

UNDER

Application No. G-1036 Permit No. G-2386

IN NAME OF

ALAN G. & VIRGINIA C. WITHERS

Surveyed JUNE 22, 1970, by R. MUCKEN