
G-3291

38092
44007
51865 > T5238
57543

T.26S.R.15E.W.M.

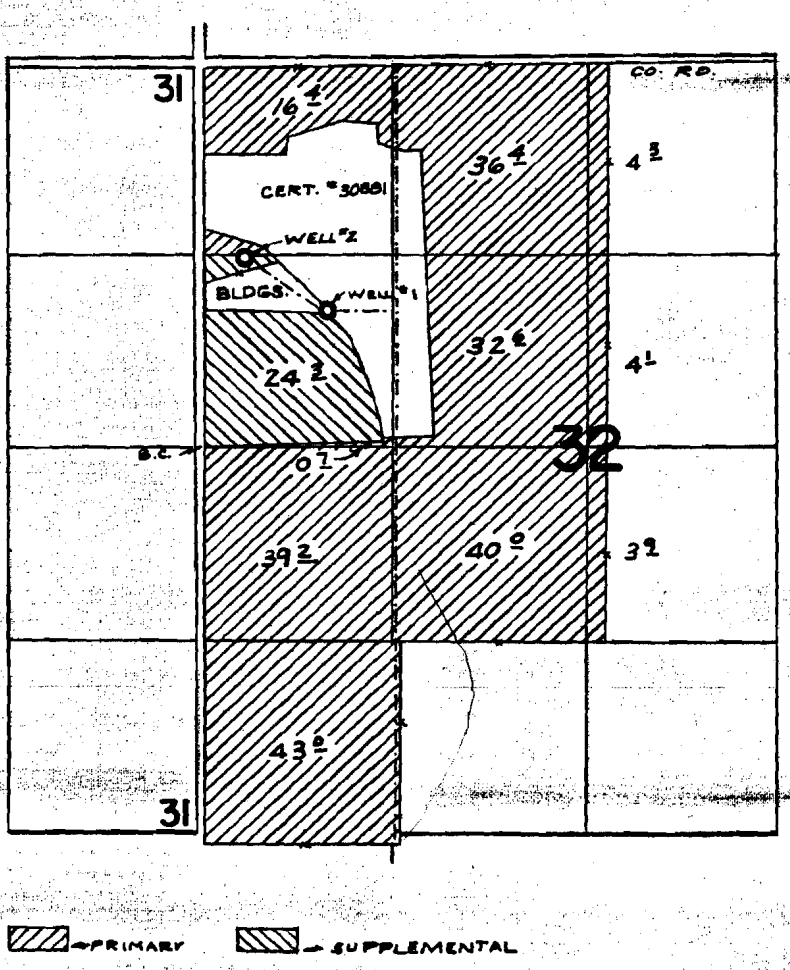

FINAL PROOF SURVEY
UNDER

Application No. G-3291. Permit No. Q-3020
IN NAME OF

ROBERT R. TUTTLE & ESTATE OF GERALDINE TUTTLE

Surveyed JUNE 23, 1970, by R. MUCKEN

1970-L & CNZ-1KK-22