


G3644 38093' 3

T.34S.R.19E.W.M.

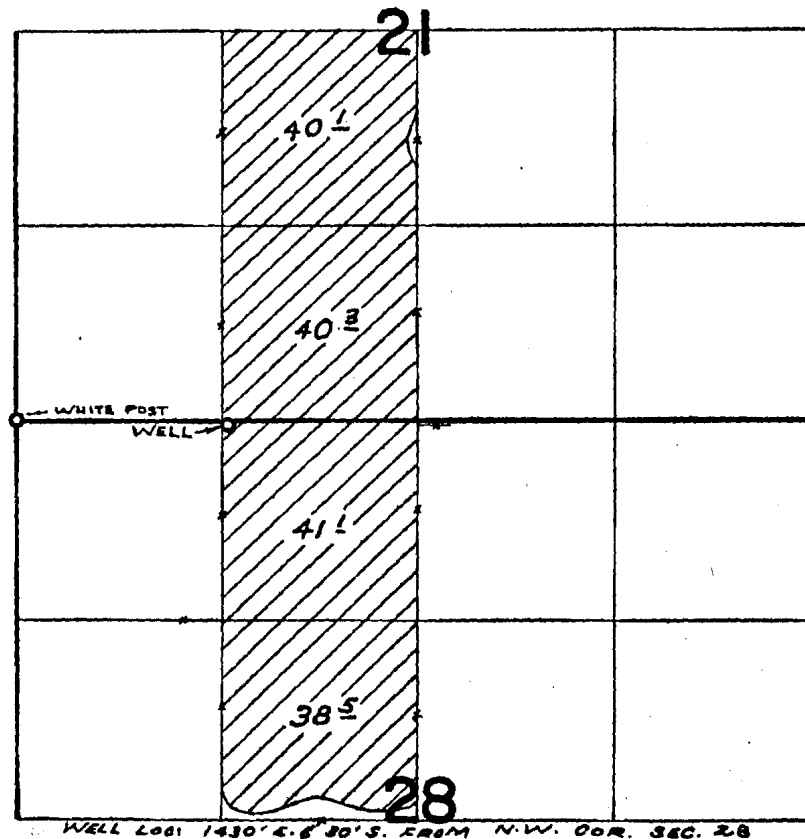

FINAL PROOF SURVEY

UNDER

Application No. G-3873 Permit No. G-3644

IN NAME OF

GILSON HAY & GRAIN

Surveyed JULY 1, 1970, by R. MUCKEN