


T.36S.R.24E.W.M.

G 1955 13
38094

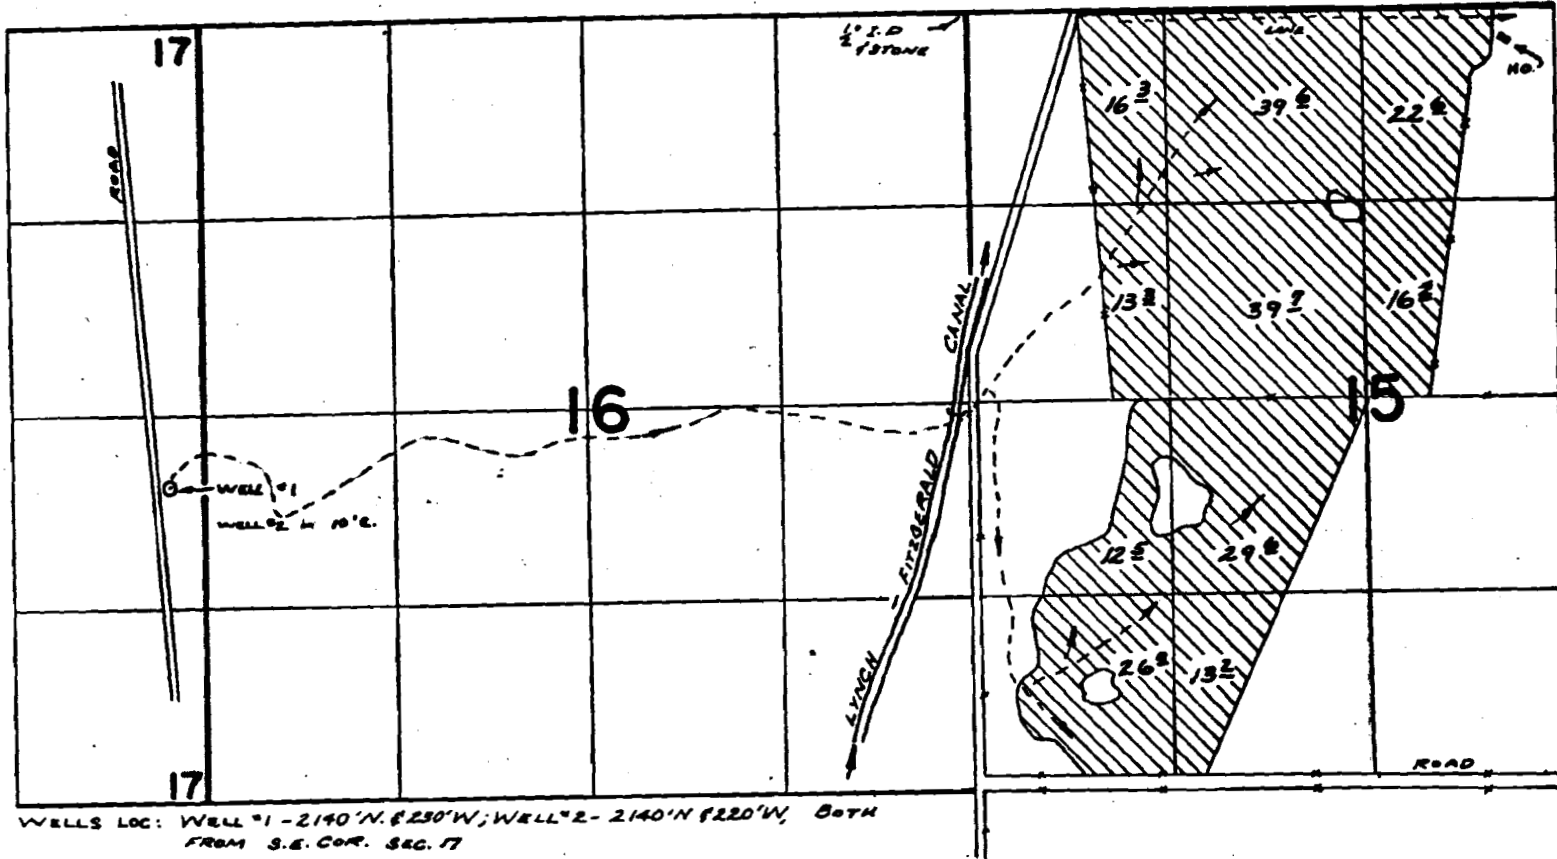

FINAL PROOF SURVEY

UNDER

Application No. G-2124 Permit No. G-1955

IN NAME OF

FITZGERALD BROS.

Surveyed July 22, 1970, by R. MUCKEN