
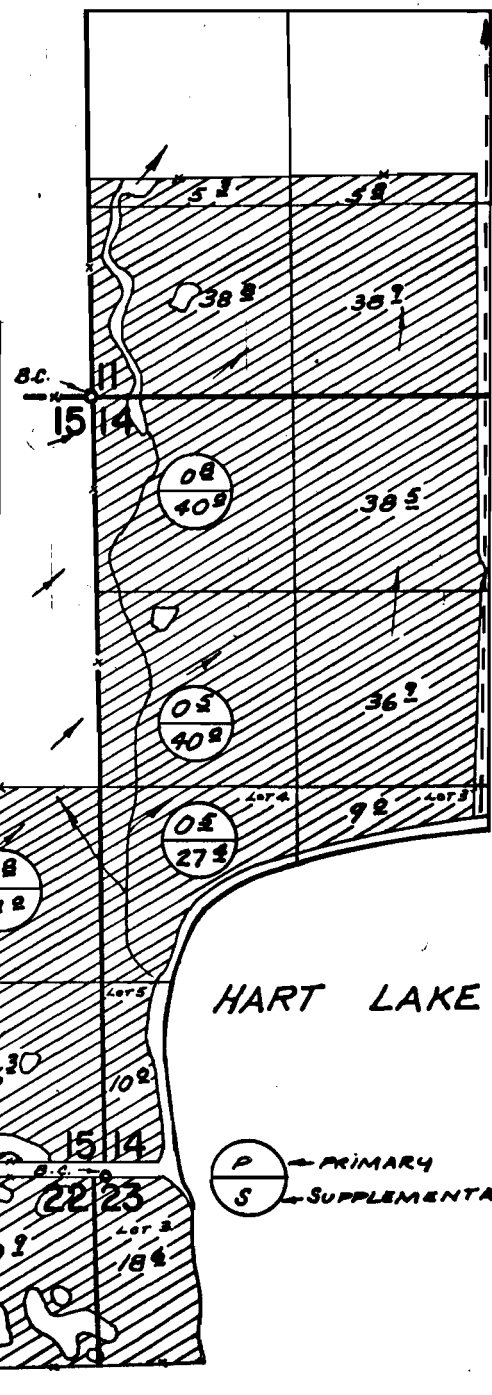


# T.36S.R.24E.W.M.

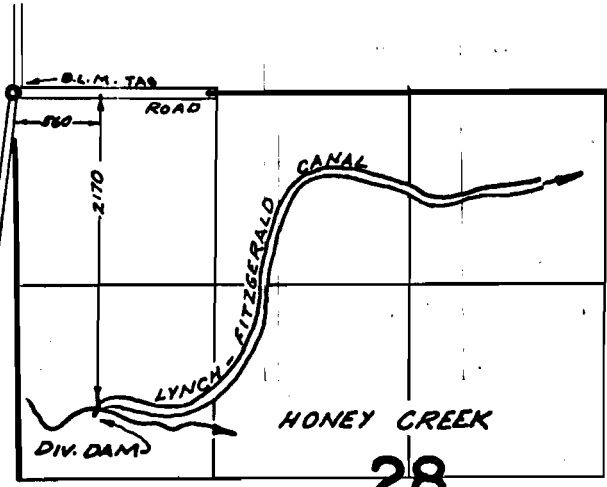

## FINAL PROOF SURVEY

UNDER

Application No. 38257 Permit No. 30445

IN NAME OF

FITZGERALD BROTHERS

Surveyed July 23 1970, by R. MUCKEN

24V