


G 2072 13
38096

T. 29S.R.17E.W.M.

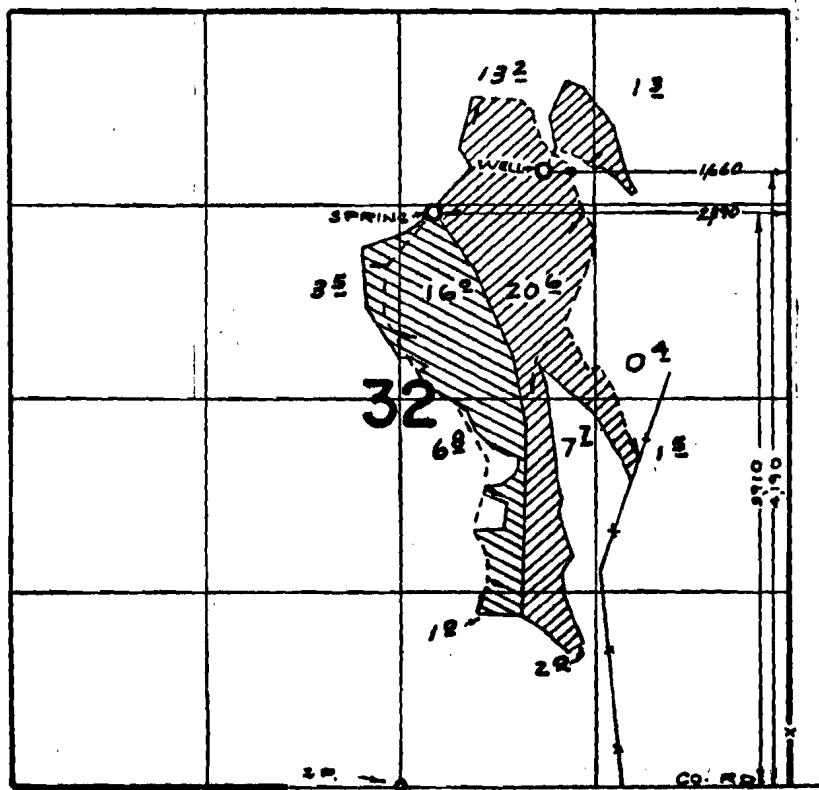

FINAL PROOF SURVEY

UNDER

Application No. G-2255 37467 Permit No. G-2072 27895

IN NAME OF

L. H. RANCH, INC.

Surveyed AUG. 8, 1968, by V. GOULD
JUNE 24, 1970 R. MUCKEN