G4263 13

38097
T9858

T. 29 S. R. 16 E. W. M.

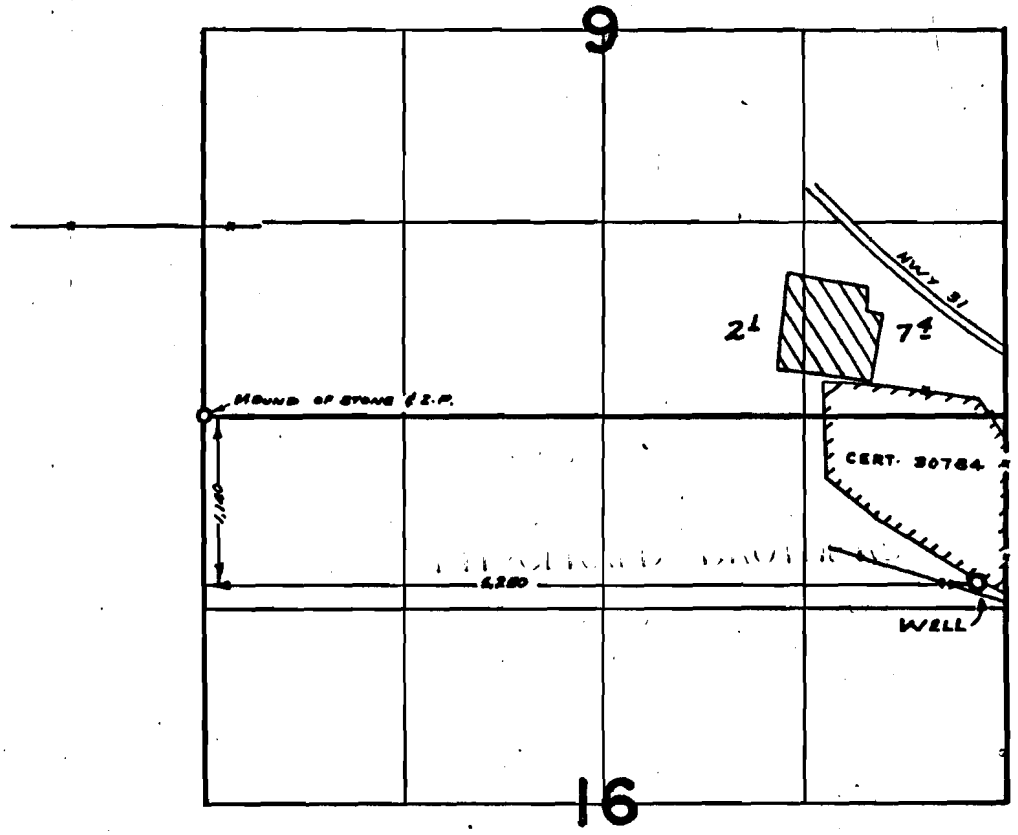

FINAL PROOF SURVEY

UNDER

Application No. G-4525 Permit No. G-4263

IN NAME OF

L. H. RANCH, INC.

Surveyed June 25 19 70, by R. MUCKEN

1770-4