P-27895 13
38098

T. 29 S. R. 17 E. W. M.

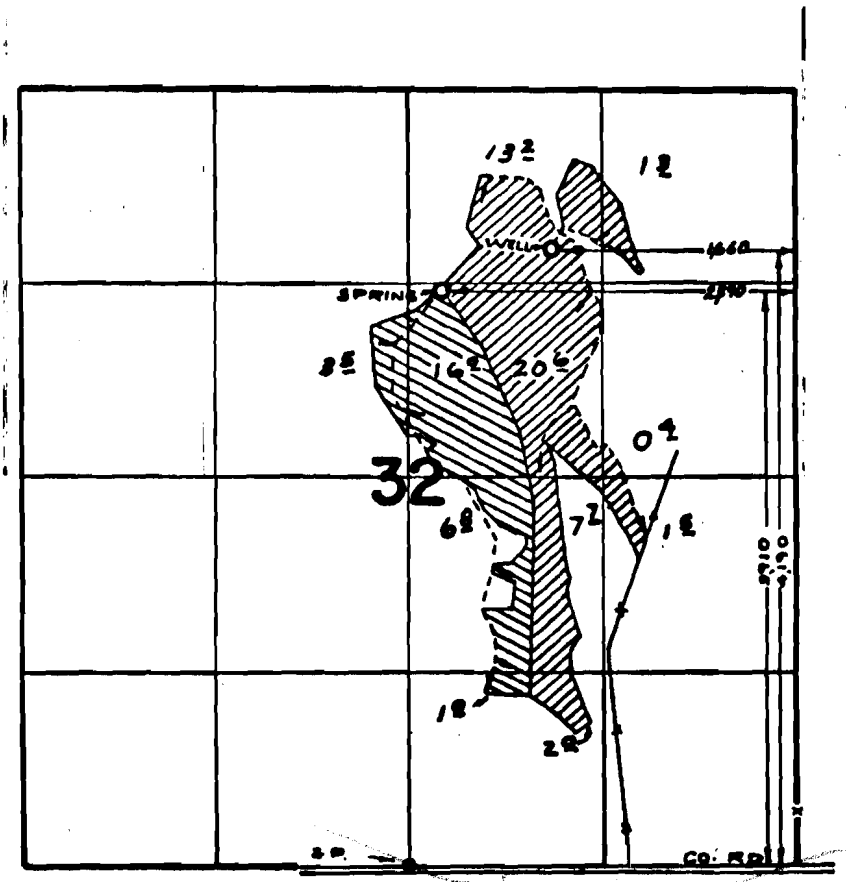

FINAL PROOF SURVEY

UNDER

Application No. G-2255 27461 Permit No. G-2072 27895

IN NAME OF

L. H. RANCH, INC.

Surveyed AUG. 6, 1969, by V. GOULD
JUNE 24, 1970 R. MUCKEN

29-17W

1968-U & 1970-L