


12 2986
38099 13

T. 36 S. R. 21 E. W. M.

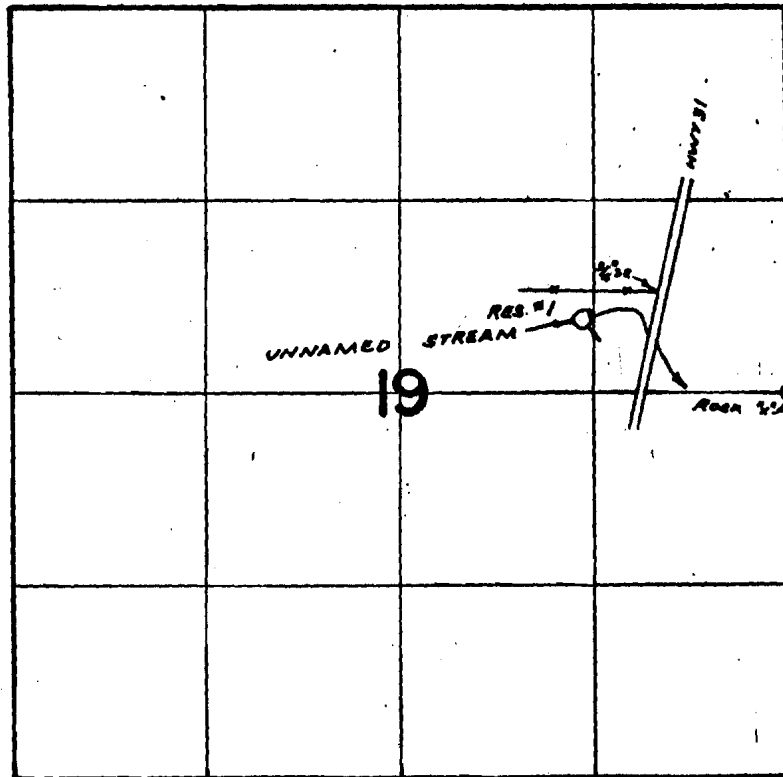

DIV. PT. LOC: 520' N & 1340' W. FROM E. & COR. SEC. 19

1970-6

FINAL PROOF SURVEY

UNDER

Application No. ~~R-37454~~ Permit No. ~~R-2986~~

IN NAME OF

DOUGLAS M. ELDER

Surveyed July 14, 1970, by R. MUCKEN

36-21 ✓