


R2987
38100 13

T.36S.R.21E.W.M.

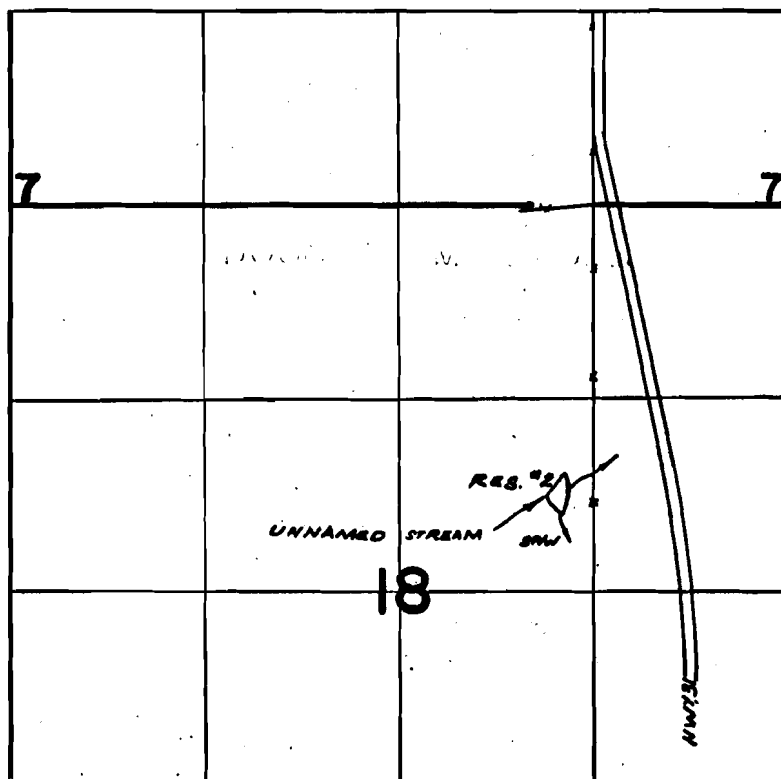

DIV. PT. LOC: 1930'S. & 170' W. FROM N.W. COR. NE 1/4 NE 1/4 SEC. 18

FINAL PROOF SURVEY

UNDER

Application No. R-37445 Permit No. R-2987

IN NAME OF

DOUGLAS M. ELDER

Surveyed July 14, 1970, by R. MUCKEN

36-21