


T.33S.R.17E.W.M.

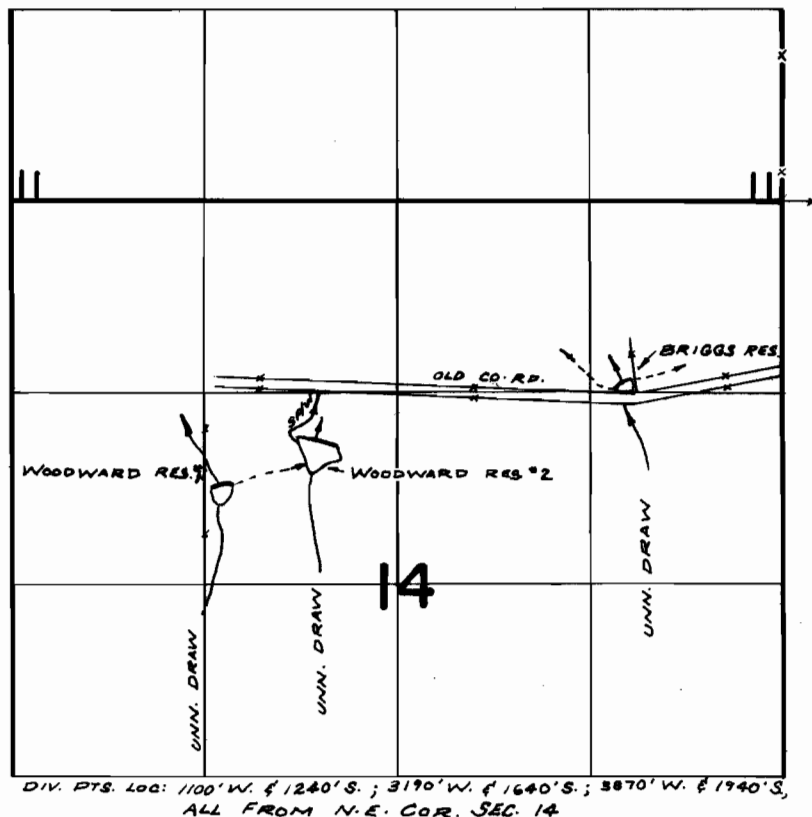

FINAL PROOF SURVEY

UNDER

Application No. R-42269 Permit No. R-4814
R-42270 R-4791
R-42271 R-4815

IN NAME OF

JOHN V WITHERS

Surveyed JUNE 22, 1970, by R. MUCKEN