


T. 38S. R. 16E. W.M.

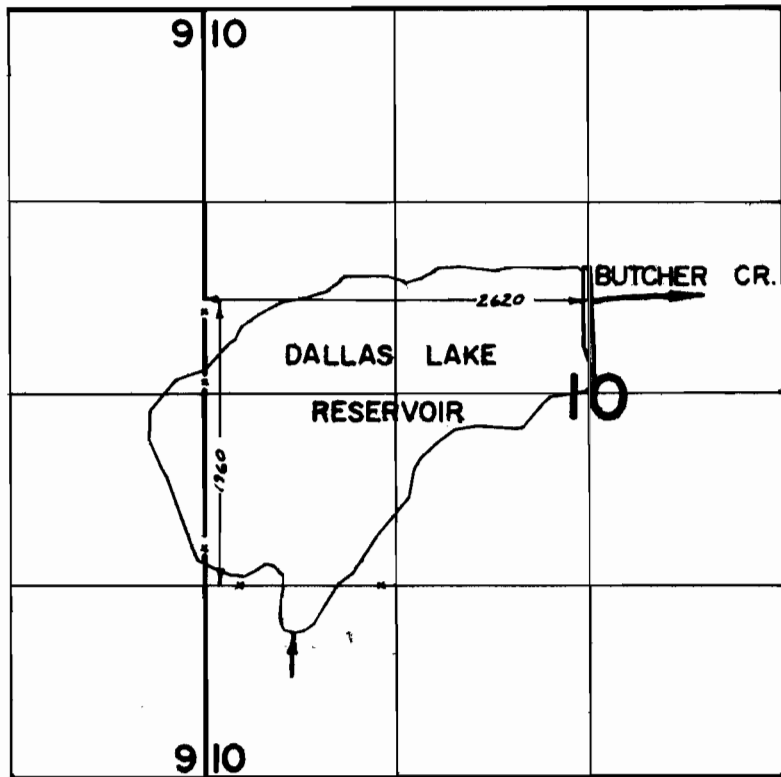

FINAL PROOF SURVEY

UNDER

Application No. R-32629 Permit No. R-2177

IN NAME OF

DREWS VALLEY RANCH

Surveyed Aug. 8, 1970, by R. MUCKEN