



T.38S.R.16&17E.W.M.

R.17E.

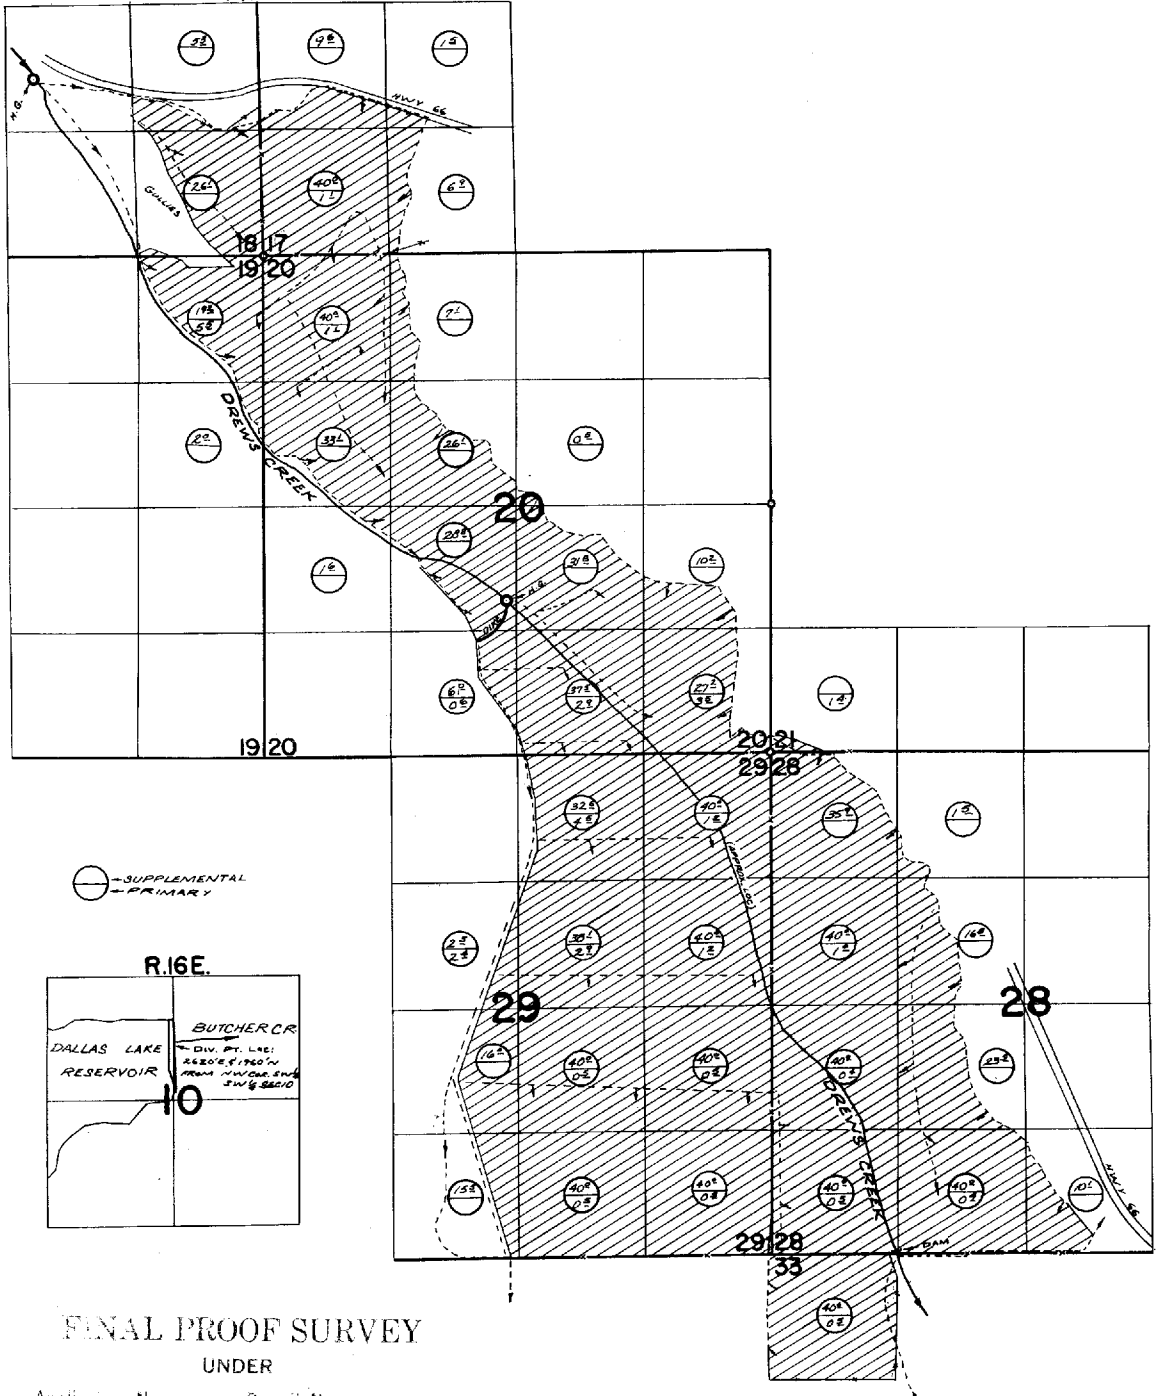

 - SUPPLEMENTAL
 - PRIMARY

R.16E.

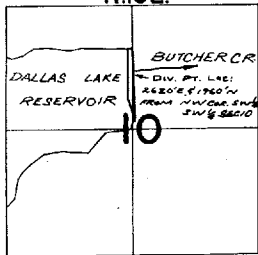

FINAL PROOF SURVEY

UNDER

Application No. 32630 Permit No. 25738

IN NAME OF

DREWS VALLEY RANCH

Surveyed Aug 2-7 1970, by R. MUCKEN