


T.31S.R.15E.W.M.

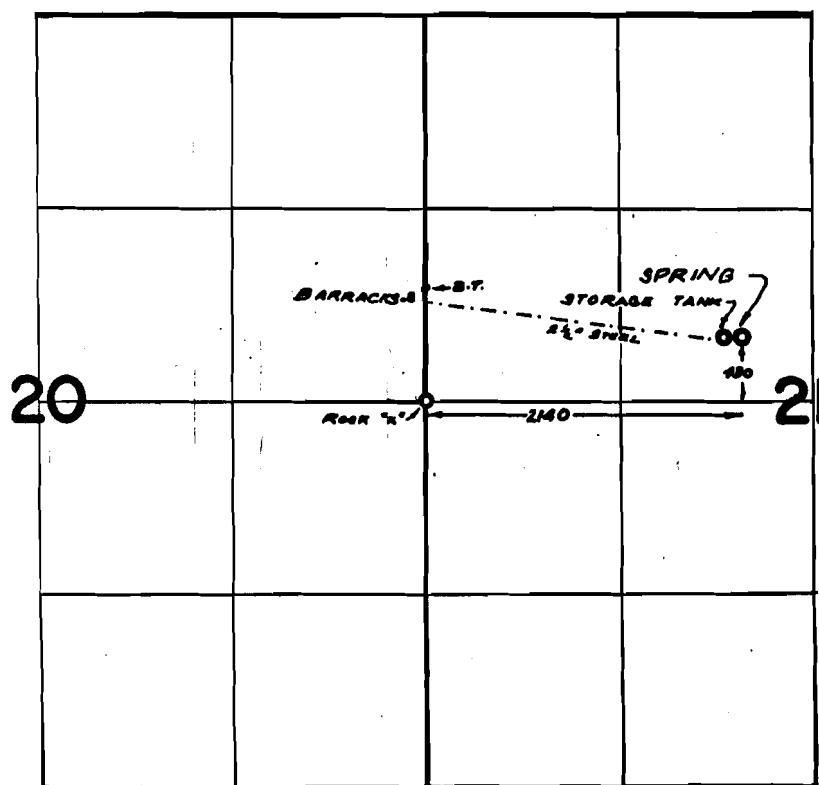

FINAL PROOF SURVEY

UNDER

Application No. 34529 Permit No. 27189

IN NAME OF

UNITED STATES OF AMERICA - FREMONT NATIONAL FOREST

Surveyed JUNE 25, 1970, by R. MUCKEN

31-15 ✓