


T.39S.R.20E.W.M.

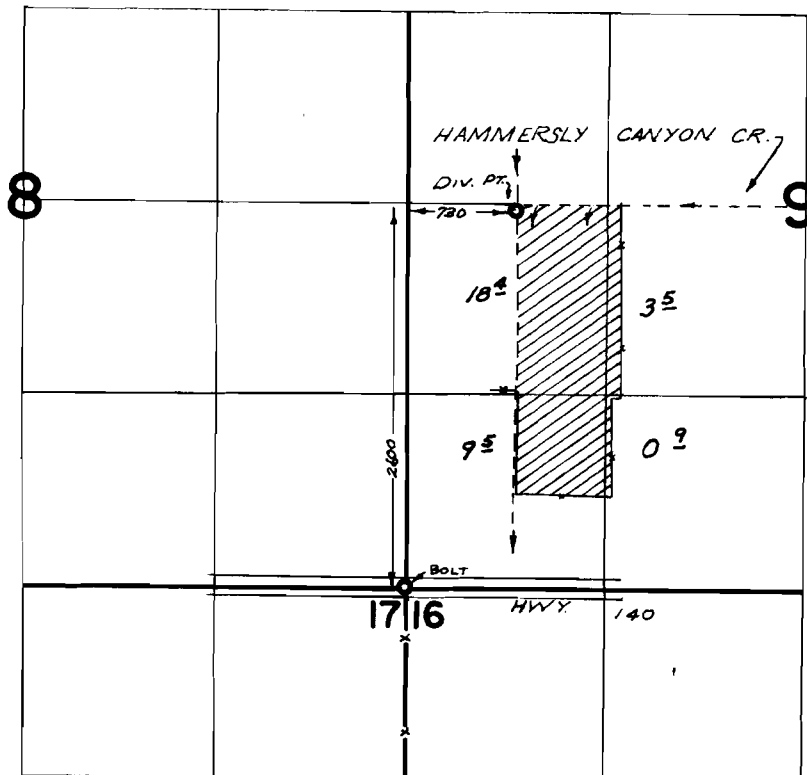

FINAL PROOF SURVEY

UNDER

Application No. 37965 Permit No. 28428

IN NAME OF

CECIL SWINGLE

Surveyed July 17, 1970, by R. MUCKEN