


P 30-708

30708

38110 13

T. 40S. R. 19E. W.M.

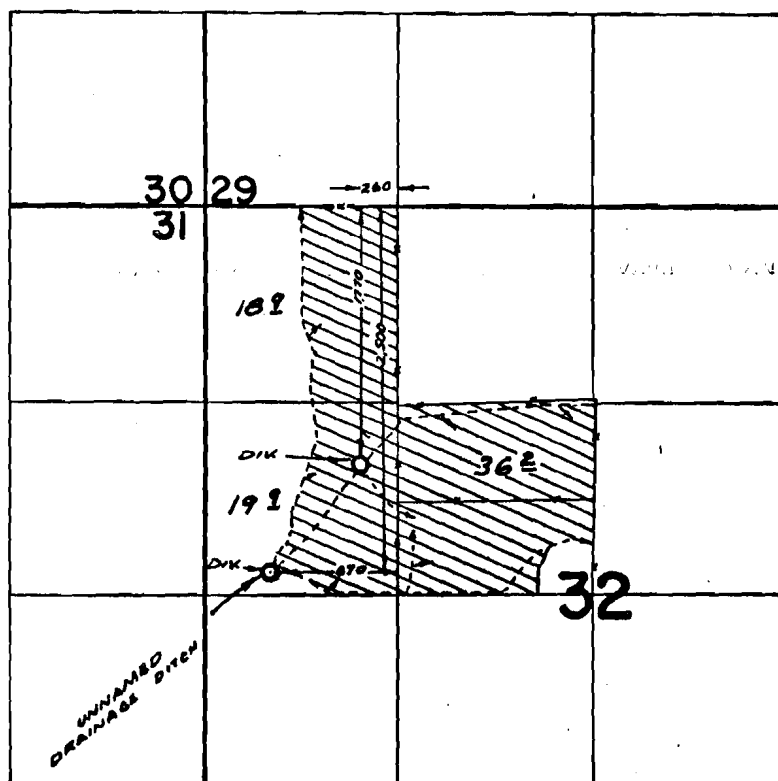

FINAL PROOF SURVEY

UNDER

Application No. 34404 Permit No. 30708

IN NAME OF

C. STANLEY THOMAS

Surveyed AUG. 10, 1970, by R. MUCKEN

40-19 ✓