


T. 39 S. R. 19 E. W. M.

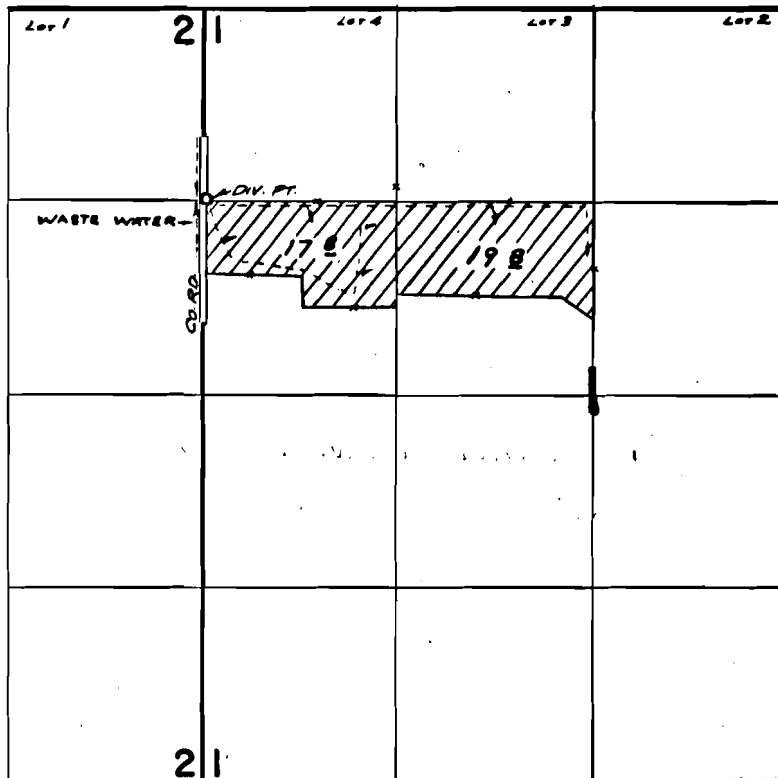

Div. Pt. Loc: 20'E. N.W COR. S.W 1/4 N.W 1/4 SEC. 1

FINAL PROOF SURVEY UNDER

Application No. 42232... Permit No. 31271.....
IN NAME OF

GEORGE E. JASKA

Surveyed AUG. 13, 1970, by R. MUCKEN...

39-19 ✓