


T. 15 & 16 S. R. 4 W. W. M.

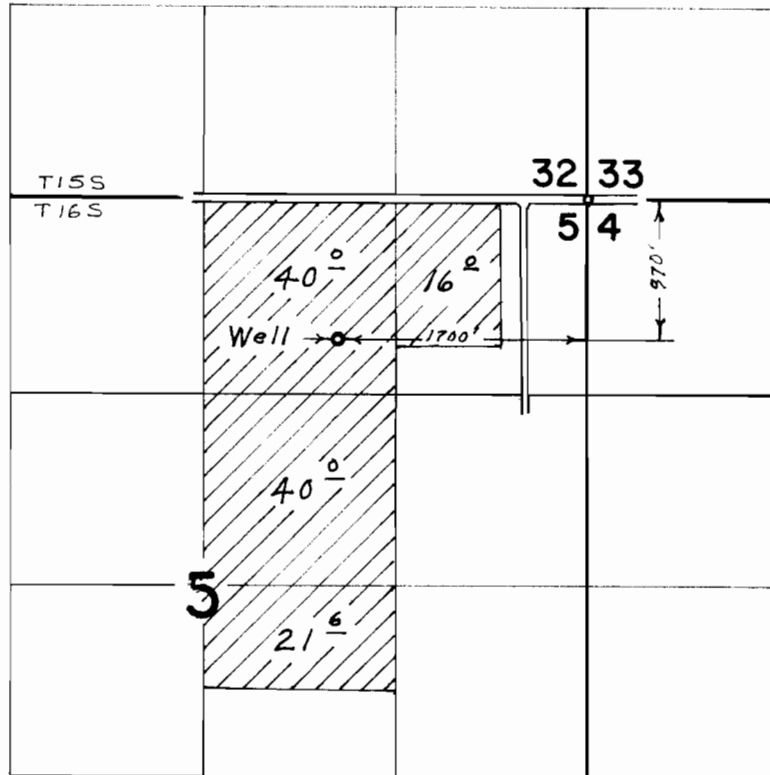

FINAL MAP OF SURVEY

BOOK G-3347 PAGE G-3143

ESTATE OF OLSE N. PETERSEN

June 19, 1970 L. E. Gould