


T. 15 S. R. 4 W. W.M.

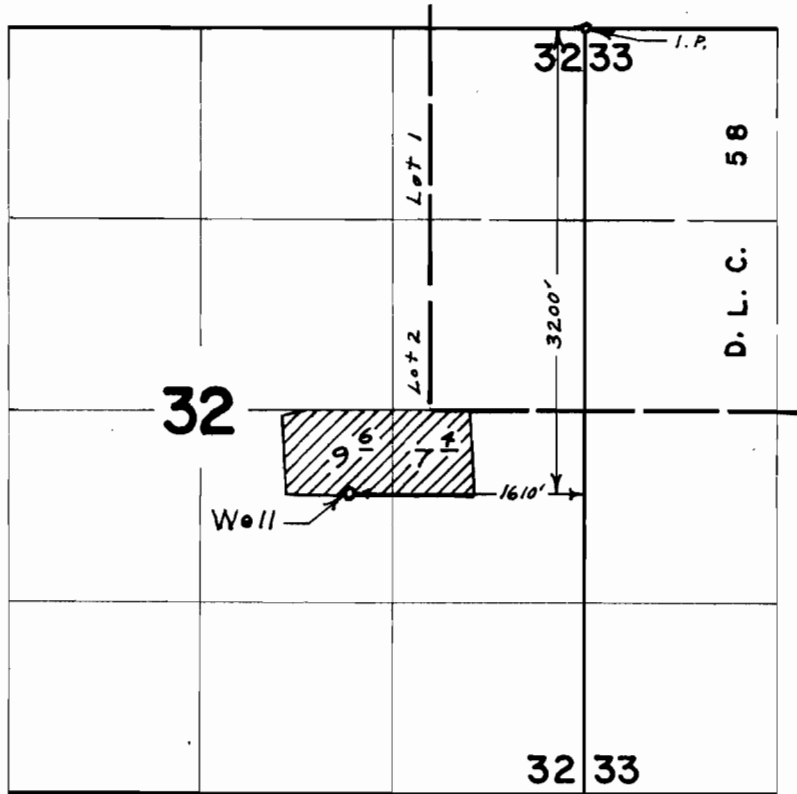

FINAL PROOF SURVEY

UNDER

Application No. G-3550 Permit No. G-3339

IN NAME OF

ARTHUR G. & ESTHER M. JAGER

Surveyed June 15, 1970, by L. E. Gould