


T.15&16 S.R.4 W.W.M.

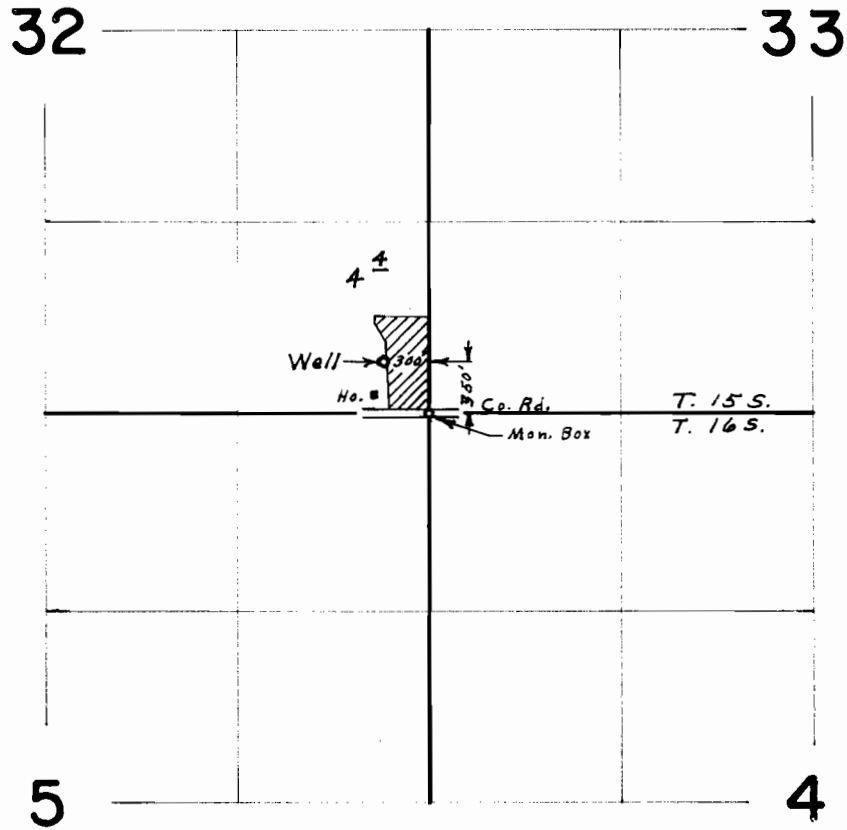

W. W. MOORE & COMPANY

G-3802

G-3588

DALE & AUDREY MOORE

June 12, 70 L. E. Gould