


T. 15 S. R. 5 W. W. M.

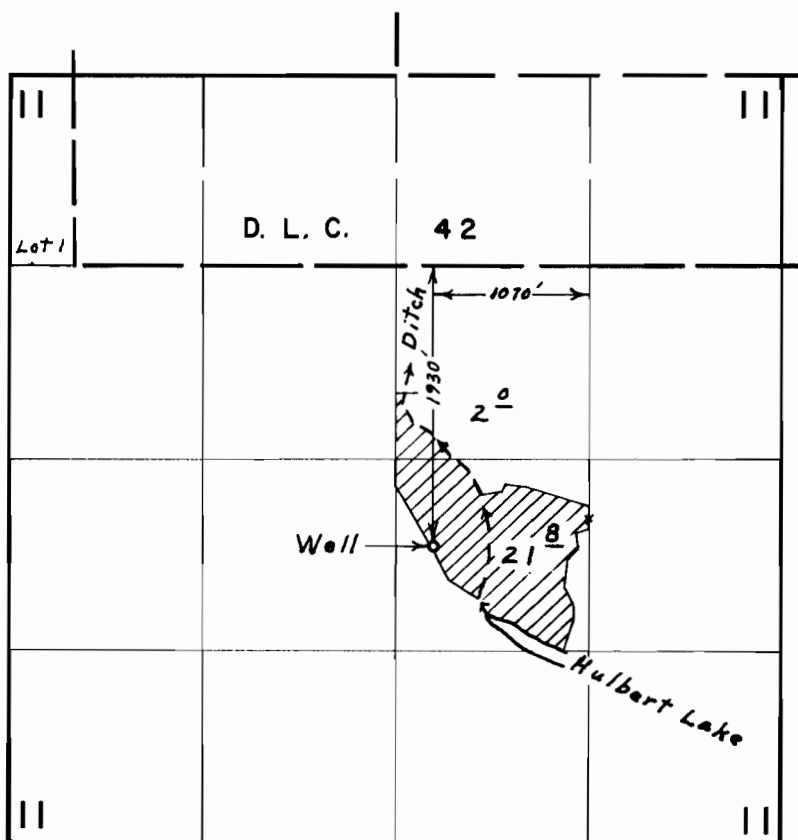

FINAL PROOF SURVEY
UNDER

Application No. G-3905 Permit No. G-3669
IN NAME OF

BOB & JEAN NIXON

Surveyed Aug. 25, 1970, by L. E. Gould.