


T.16S.R.4W.W.M.

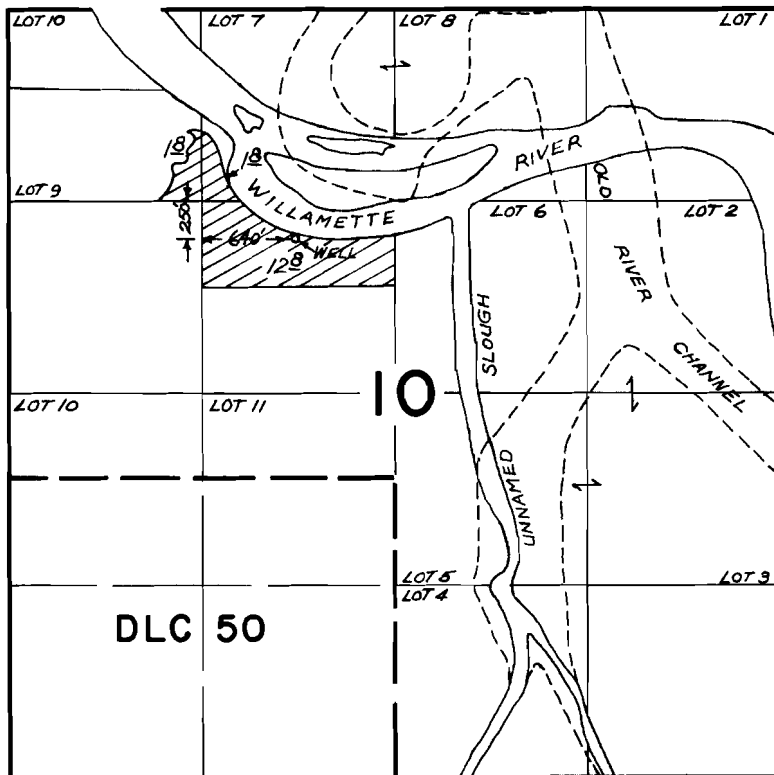

FINAL PROOF SURVEY UNDER

Application No. G-4139 Permit No. G-3949
IN NAME OF

CLYDE R. & SHARON A. WILLIS

Surveyed SEPT. 18, 1970, by L.E. GOULD