



T.16 & 17 S. R.3 W. W.M.

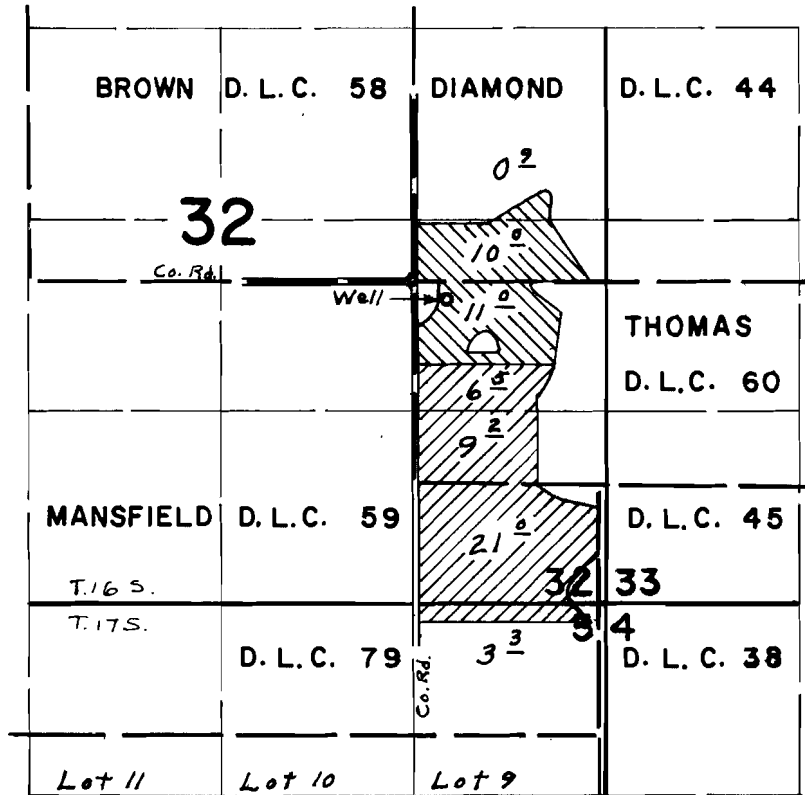

Well located 120' S & 220' E. from S.E. Cor. Brown D.L.C. 58

Primary 

Supplemental 

FINAL PROOF SURVEY

UNDER

Application No. G-4217 Permitted by G-3981

IN NAME OF
GREEN BROS.

Surveyed June 18, 1970, by L. E. Gould