T. 16 S. R. 3 W. W.M.

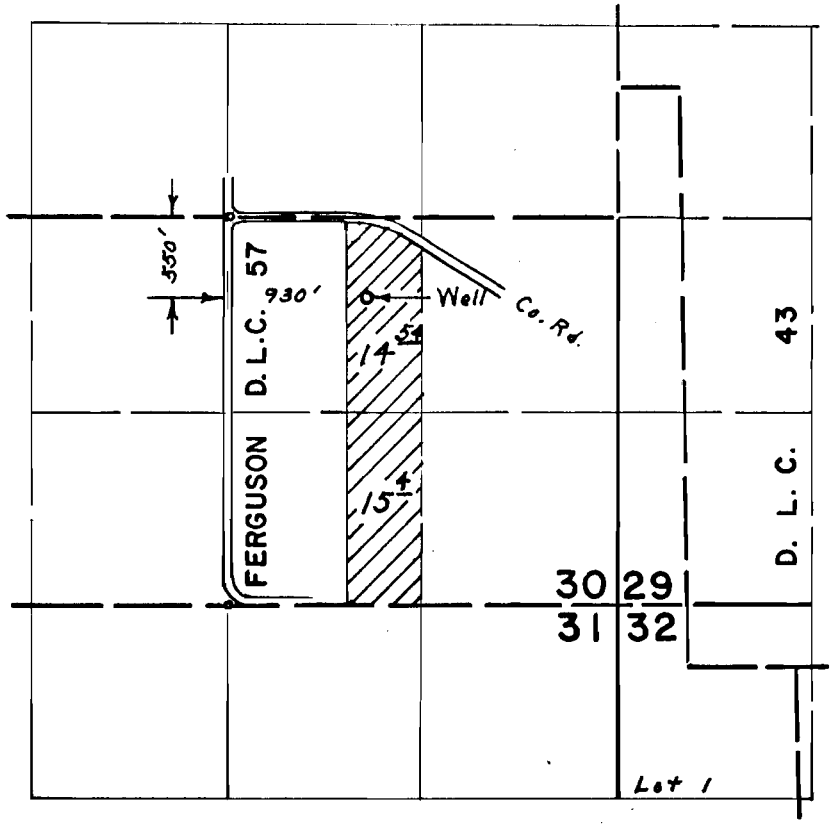

FINAL PROOF SURVEY

UNDER

Application No. G-4307 Permit No. G-4068

IN NAME OF

STEPHEN KENNETH COBURN

Surveyed June 17, 1970, by L. E. Gould

DBQ-2JJ-88 & 1970-U