


T. 15 S. R. 5 W. W. M.

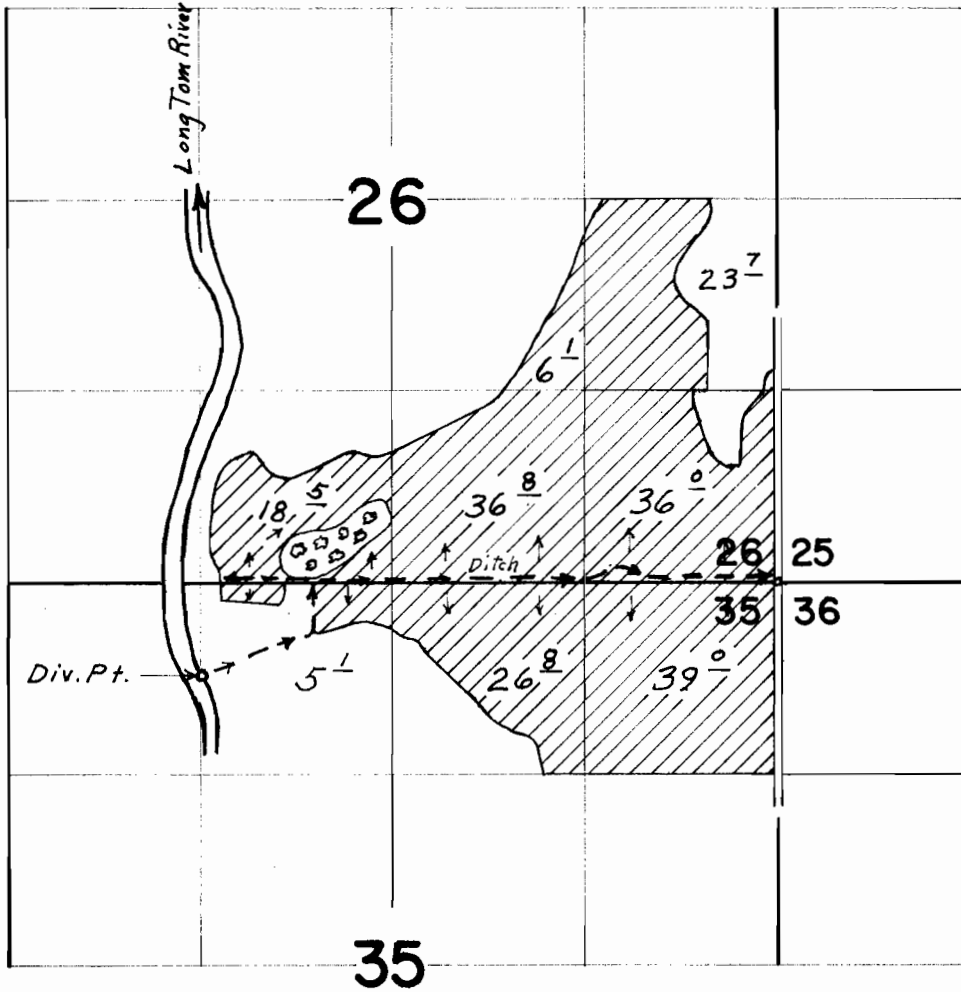

Div. Pt. located 630' S. of 3940' W. from N.E. Corner Section 35

[illegible]

43353

3 2 4 0 2

FRANK A. JACKSON & ESTATE OF SHIRL A. JACKSON

June 11, 70 L. E. Gould