


T. 15 S. R. 5 W. W.M.

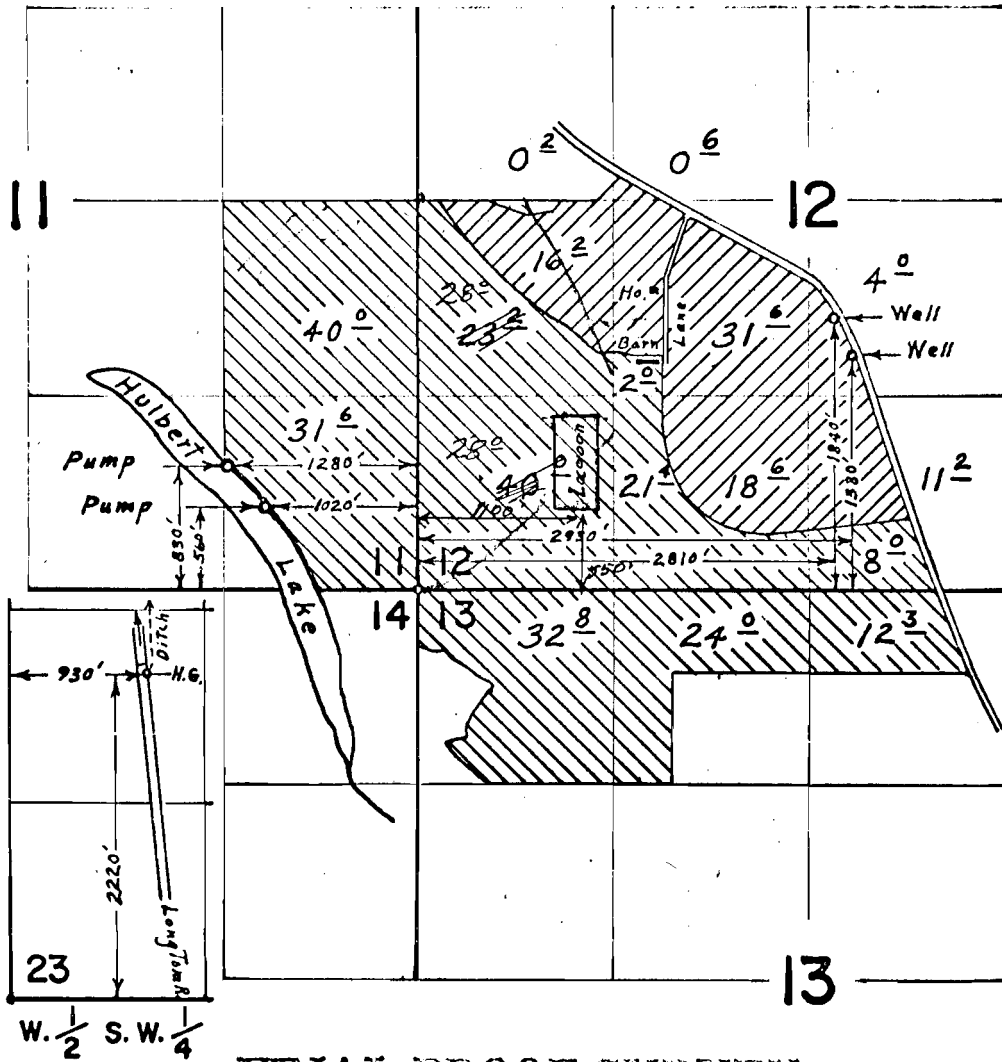

FINAL PROOF SURVEY

UNDER

Application No. G-4272 44562 Permit No. G-4023 33415



IN NAME OF

HOWARD & GLADYS GIBSON

Surveyed June 5, 1970, by L. E. Gould