


T. 15 S. R. 5 W. W.M.

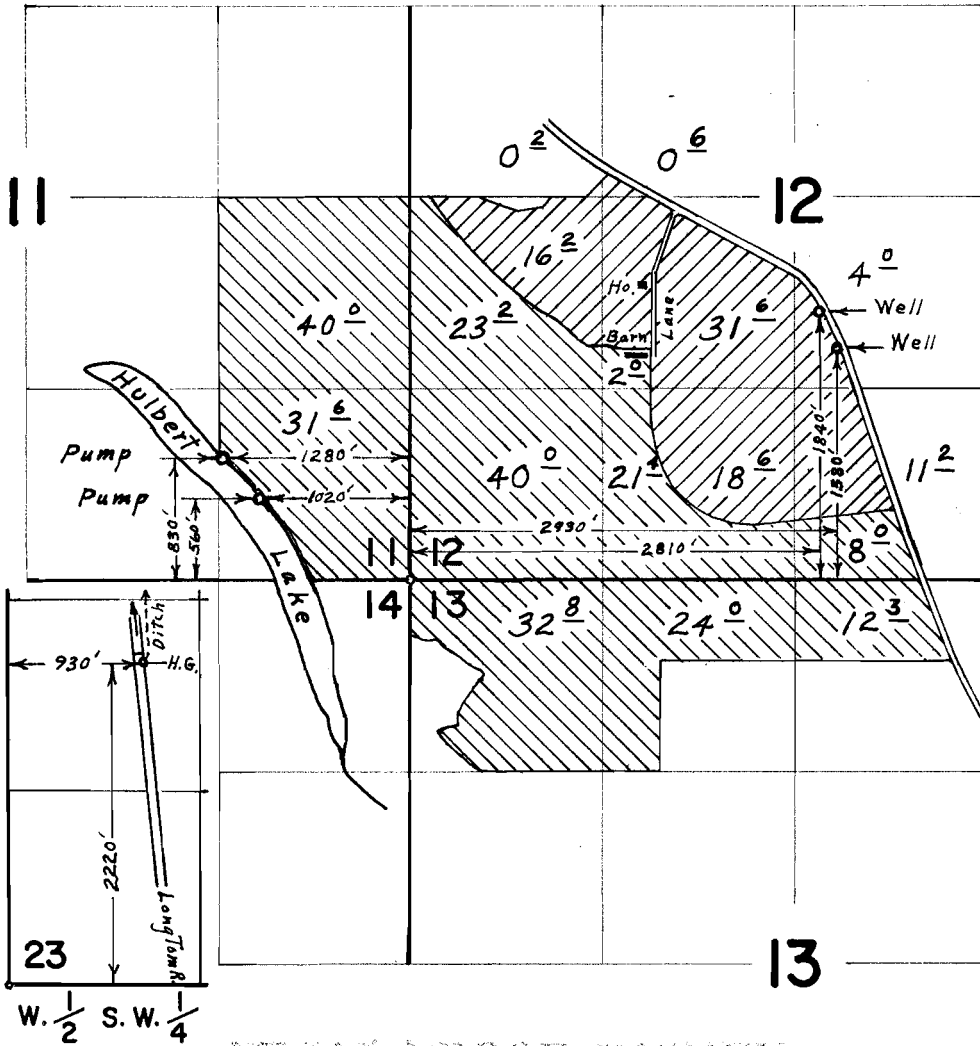

FINAL PROOF SURVEY

UNDER

Applicant No. **G-4272** 44562 Serial No. **G-4023** 33415

IN NAME OF

HOWARD & GLADYS GIBSON

Surveyed **June 5, 1970** by **L. E. Gould**