


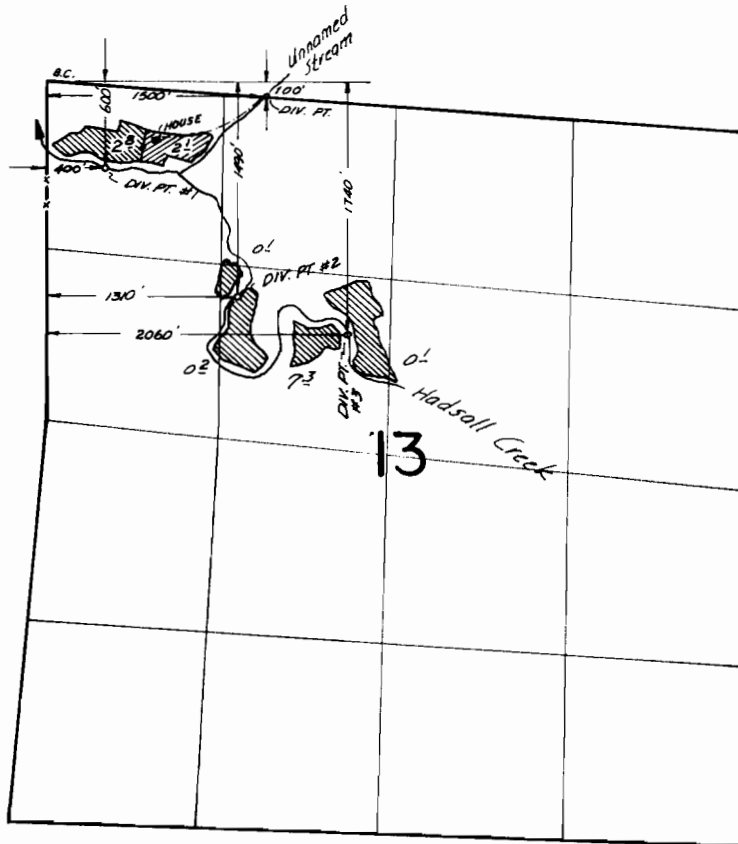

T.18S.R.10W.W.M.



-  from unnamed stream
-  from Hadsall Creek

FINAL PROOF SURVEY UNDER

Application No. 38292 Permit No. 28523
IN NAME OF

IVAN W. & IONE REED

Surveyed March 24 1970, by V.R. Garner