


T. 8 S. R. 39 E. W. M.

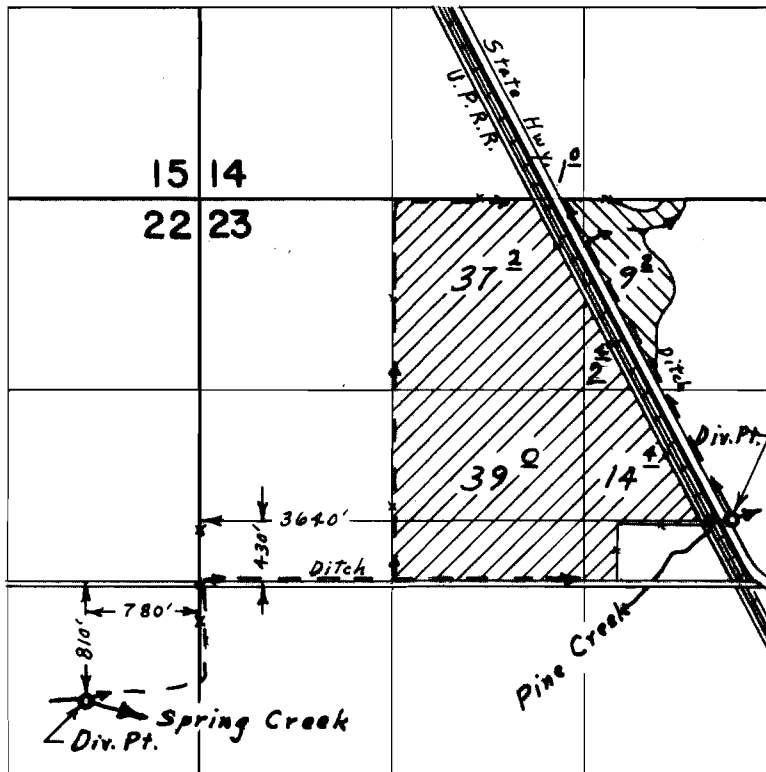

FINAL PROOF SURVEY UNDER

Application No. 41892 Permit No. 31355
IN NAME OF

GLYNN PAYTON

Surveyed July 8, 1970, by L. E. Gould