


T.17S.R.3W.W.M.

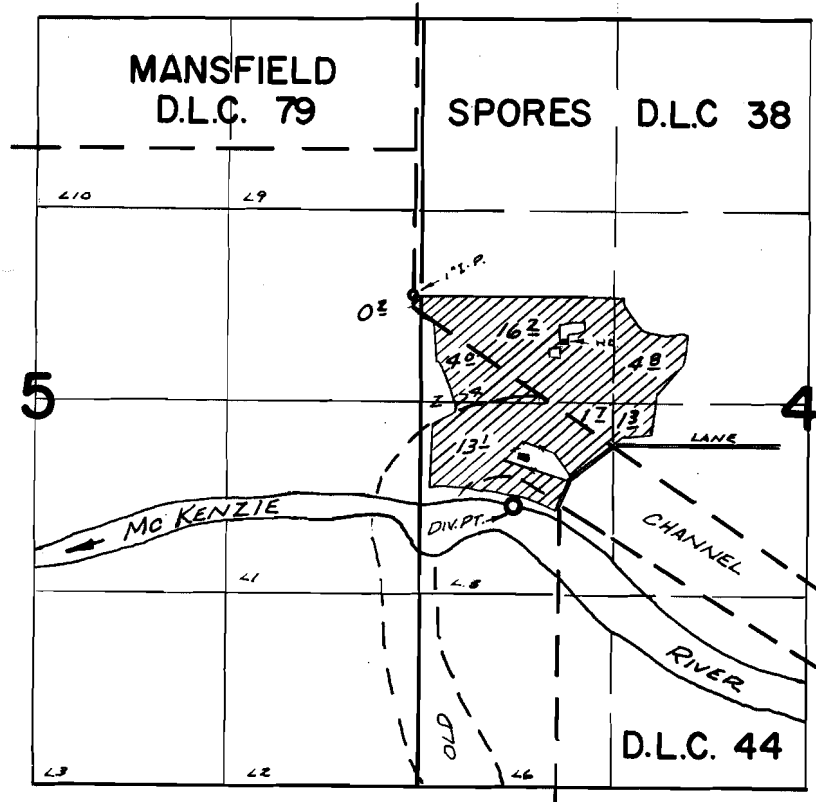

Div. Pt. Loc: 1360'S. & 670'E. FROM S.W. COR. SPORES D.L.C. 38

FINAL PROOF SURVEY UNDER

Application No. 40755 Permit No. 30382
IN NAME OF

NEILS EGGE

Surveyed Nov. 13 1970, by R. MUCKEN.