


T.16S.R.7W.W.M.

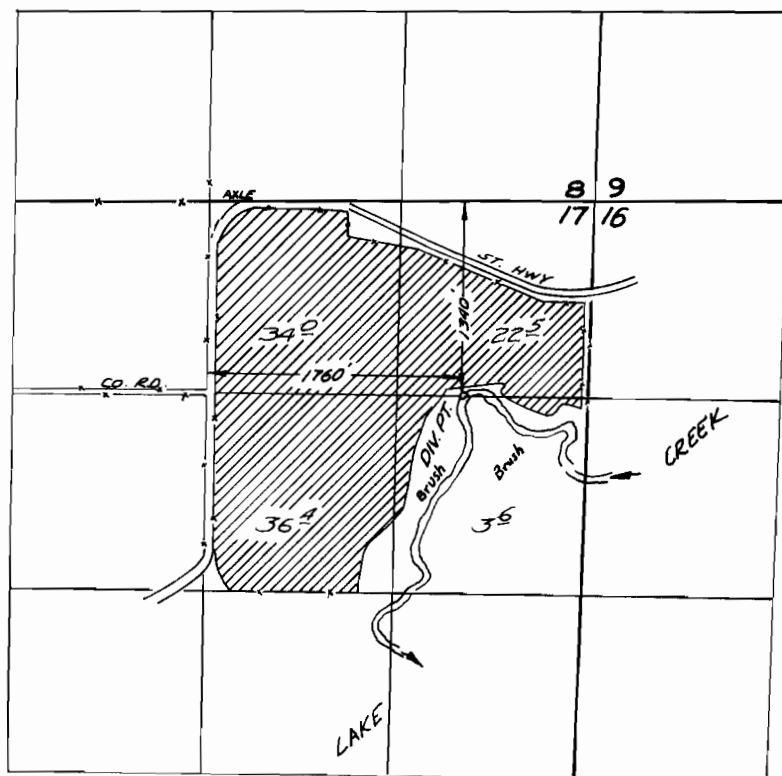

FINAL PROOF OF SURVEY
UNDER

Application No. 41916 Permit No. 31375
IN NAME OF

JOHN GRIFFITH

Surveyed March 25 1970, by V. R. Garner