


T.16S.R.7W.W.M.

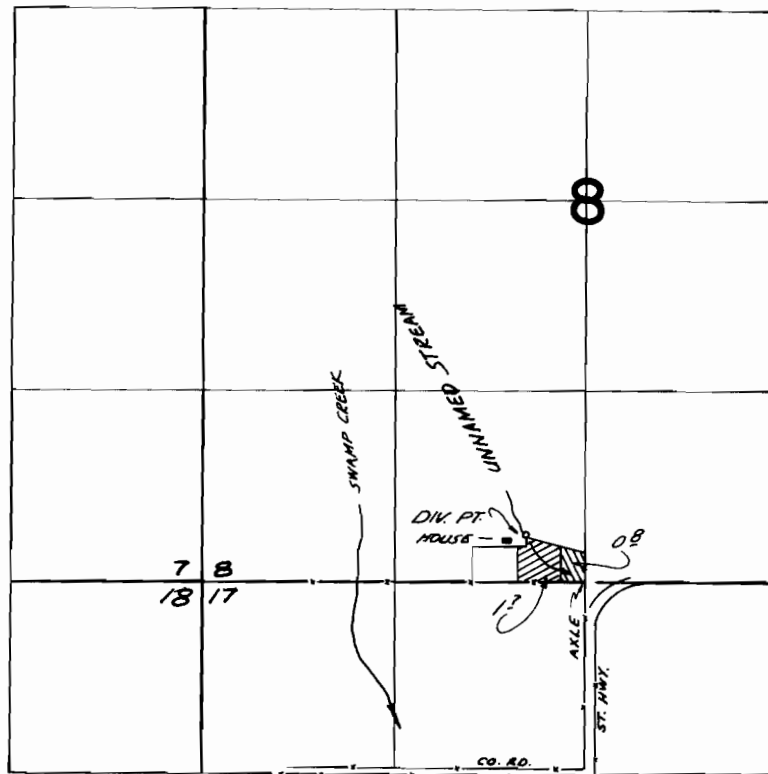

DIV. PT. LOCATED:- 320 FT. N. & 400 FT. W. FROM THE S. E. CORNER OF SECTION 8

 PRIMARY IRRIGATION
 SUPPLEMENTAL IRRIGATION

FINAL PROOF SURVEY UNDER

Application No. 41917 Permit No. 31376
IN THE NAME OF

JOHN GRIFFITH

Signed March 25 TO V.R. Garner.....