


T.18S. R.2 & 3 W.W.M.

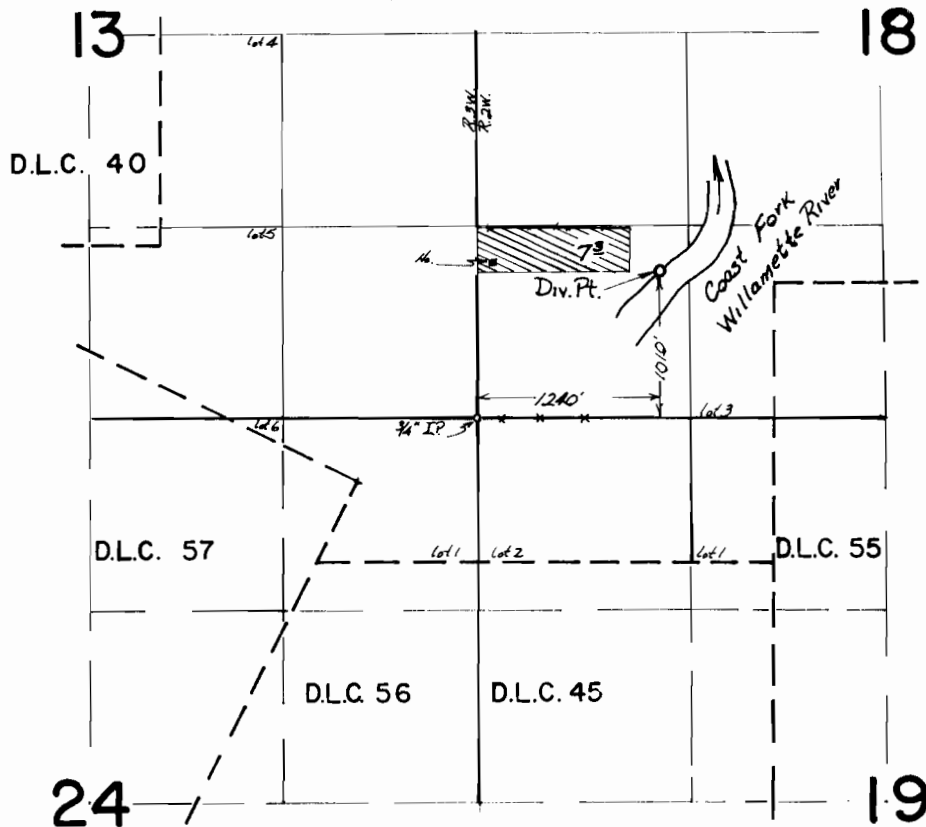

FINAL PROOF SURVEY UNDER

Application No. 42697 Permit No. 31589
IN NAME OF

EVERETT E. MEADOR

Surveyed 8. SEPT. 1971, by G. BACA