


T.15 S. R. 5 & 6 W. W. M.

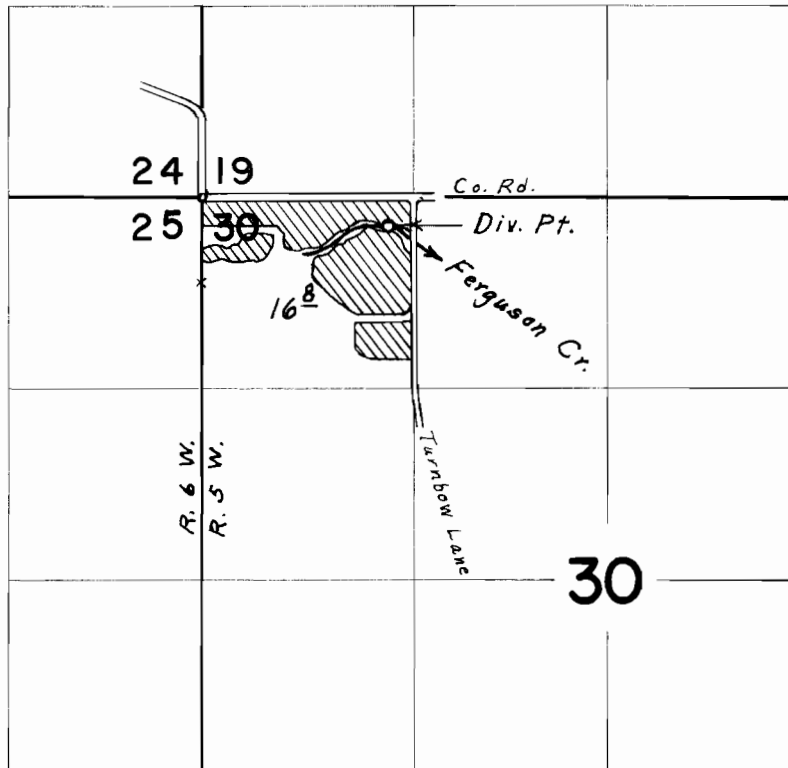

Div. Pt. located 190' S. & 1270' E. from N.W. Cor. Sec. 30

FINAL PROOF SURVEY
UNDER

Application No. 42477 Permit No. 31767
IN NAME OF

FRED J. BLAKE

Surveyed Aug. 28, 1970, by L. E. Gould