


T. 15 S. R. 5 W. W. M.

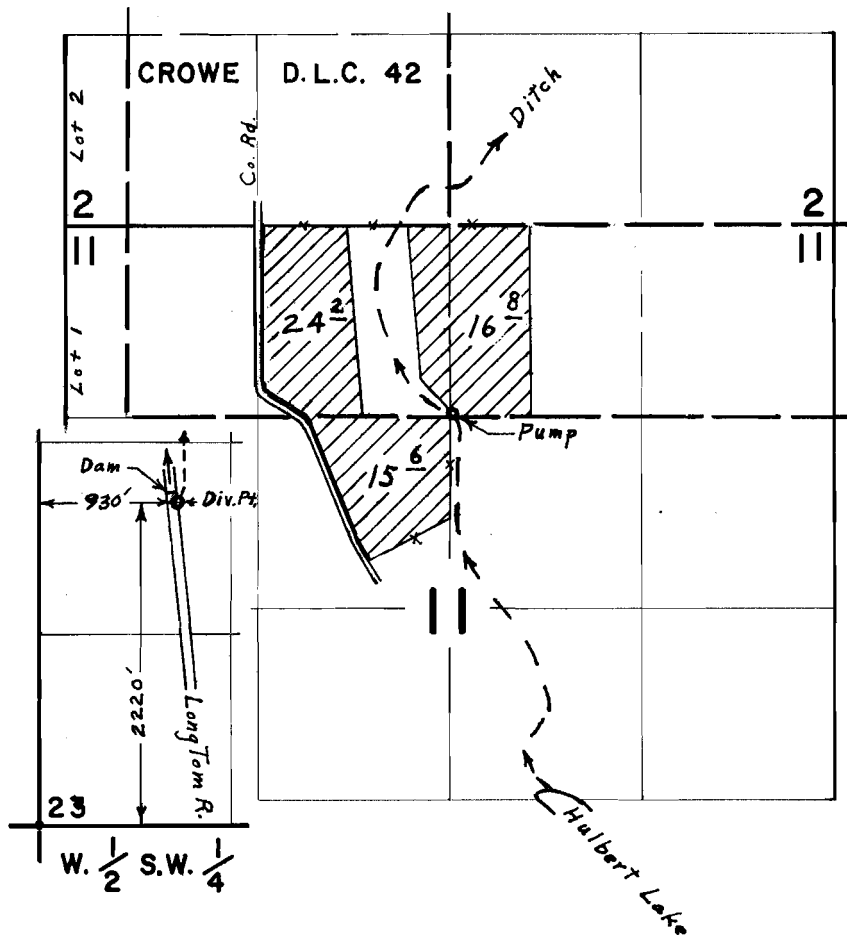

FINAL PROOF SURVEY

UNDER

Application No. 44577 Permit No. 33367

IN NAME OF

ROBERT McNees

Surveyed June 12, 1970, by L. E. Gould