


T.15S.R.5W.W.M.

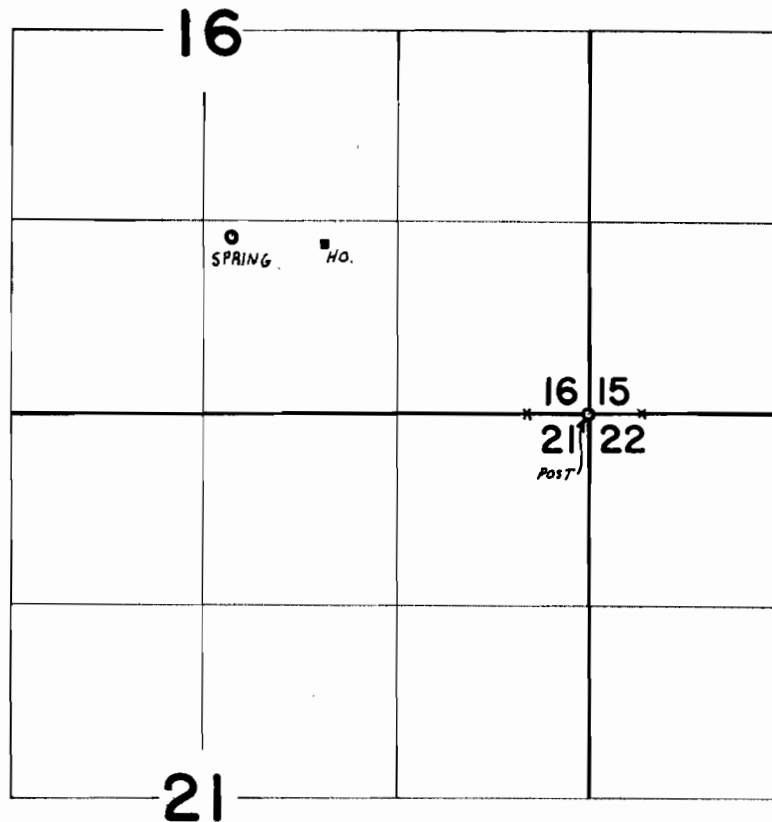

SPRING LOC. 1230' N. & 2750' W. FROM SE COR. SEC. 16

FINAL PLAT SURVEY

UNDER

Application No. 44869 & 33549

IN NAME OF

JOHN CALKINS and ROSE CALKINS

Surveyed AUG. 27 1970

L.E. GOULD