


T. 15 S. R. 1 W. W. M.

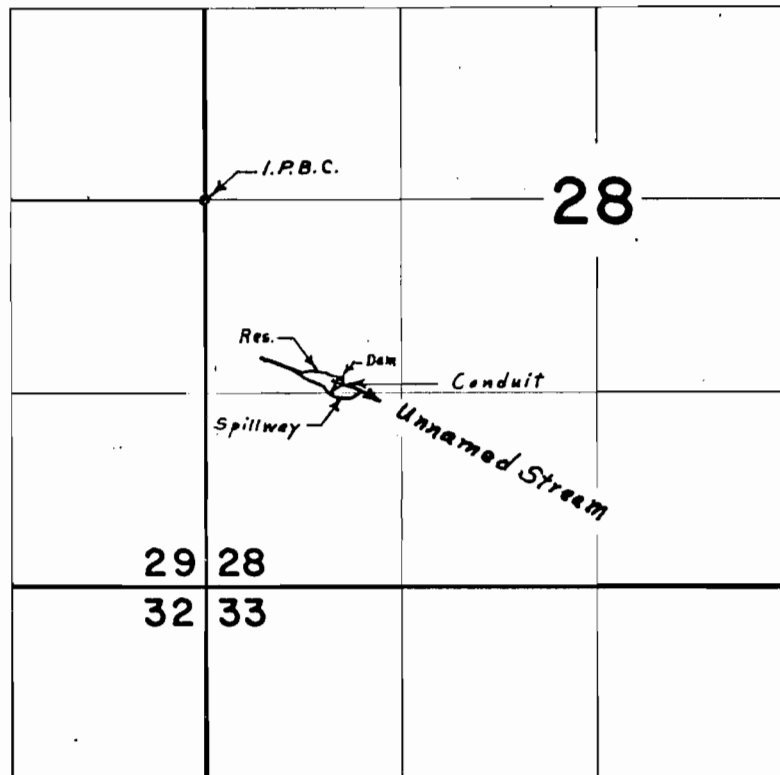

Div. Pt. located 1240' S. & 870' E. from W. $\frac{1}{4}$ Cor. Sec. 28

FINAL PROOF SURVEY

UNDER

Application No. R-45294 45295 Permit No. R- 5344 33819

IN NAME OF

R. M. BEDORTHA

Surveyed June 16, 1970, by L. E. Gould